

Joe Jackson 4H

State Well Report

Part 1

Mississippi Department of Environmental Quality
Office of Land and Water Resources
P.O. Box 10631
Jackson, MS 39289-0631
(601)961-5210
(601)354-6938 (fax)

County: Amite
 Permit #: _____
 Driller: John W Thompson
 Date drilling completed: 3-31-12

For Office Use Only:
 Aquifer: M101
 Well #: _____
 L. S. Elevation: _____
 E-log #: _____

State Law requires that this report be prepared by the driller in detail and filed with the Department within 30 days of completion of drilling of the well.

Well Owner Information	Well Location
Owner Name: <u>Encana Oil + Gas</u>	Latitude: <u>31.10.17</u> Longitude: <u>90.54.36</u>
Mailing Address: <u>Rt 2 Box 2462 hwy 786</u> <u>P.O. Box 1457</u> <u>Coushatta, LA 71019</u> City State Zip Code	Method of Lat/Long (circle one): Conventional Survey, USGS quad, <u>Hand-held GPS</u> , Survey-grade GPS <u>NW 1/4 NE 1/4 Sec 4</u> Twn <u>2N</u> Rng <u>3E</u>
Telephone No. () _____	Distance Direction Nearest Town <u>6</u> Miles <u>W</u> of <u>Liberty</u>

Well Data

Purpose of Well (circle one) Home Industrial Public Supply Irrigation Fish Culture Other: rig supply

Date well drilling started: 3-29-12 Date well drilling completed: 3-31-12

If flowing, method of flow regulation: Valve _____ Other (describe) _____

Static Water Level: 194 feet above or below (circle one) land surface Date measured: 3-31-12

Method of Measurement (circle one) steel tape electric tape air line other: _____

Hole depth: 523 Well depth: 520 Well grouted to a depth of 20 feet

Type of grout (circle one): Cement Bentonite Mix

Casing length: 440 feet Casing diameter: 4 inches Type of casing: PVC

Screen length: 80 feet Screen diameter: 4 inches Type of screen: PVC Slotted

Screen slot size: .008 inches Setting depth: From 440 feet to 520 feet

Type of completion (circle all applicable): Gravel packed Underreamed Telescoped Open hole Natural Development

Other (describe): _____

Top of lap pipe or reduction in casing: _____ feet. If telescoped or more than one screen, describe on back of page

Logs run (circle all applicable): No log run Electric Gamma Ray Density Sonic Neutron Other: _____

Name of organization running log(s): _____

I certify that the well was drilled, constructed, and completed in accordance with all applicable requirements of the Mississippi Department of Environmental Quality and/or the Mississippi Department of Health regulations and state laws.

John W Thompson 0-6 79
Print Name of Water Well Contractor and License No.

John W Thompson
Signature of Water Well Contractor

RECEIVED


APR 09 2012

BY: OLWR

M101

If well telescopes please sketch below and show depths.


Ground Level

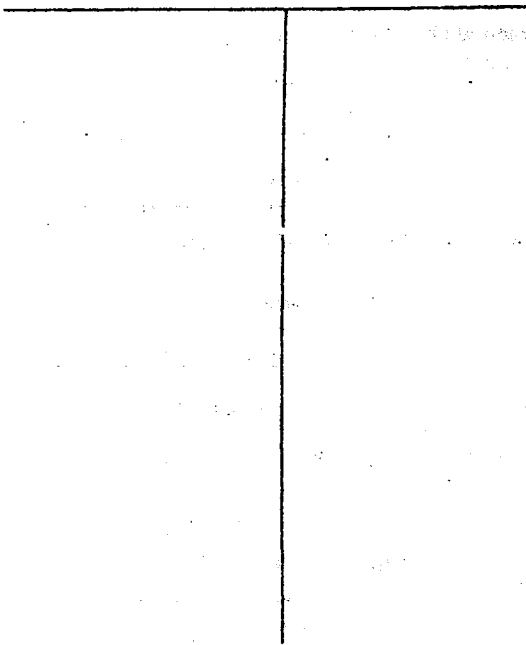

Description of Formations Encountered	From	To
Sand & gravel	0	70
White Clay	70	400
Clay & sand strips	400	460
Sand	460	523

More than one screen, show location of each on sketch

Sketch the property layout and include the following: 1) the well location; 2) any permanent structures on the property that may aid in locating the well; 3) any roads, power-lines, or other items that may aid in locating the property and the well; 4) indicate direction.

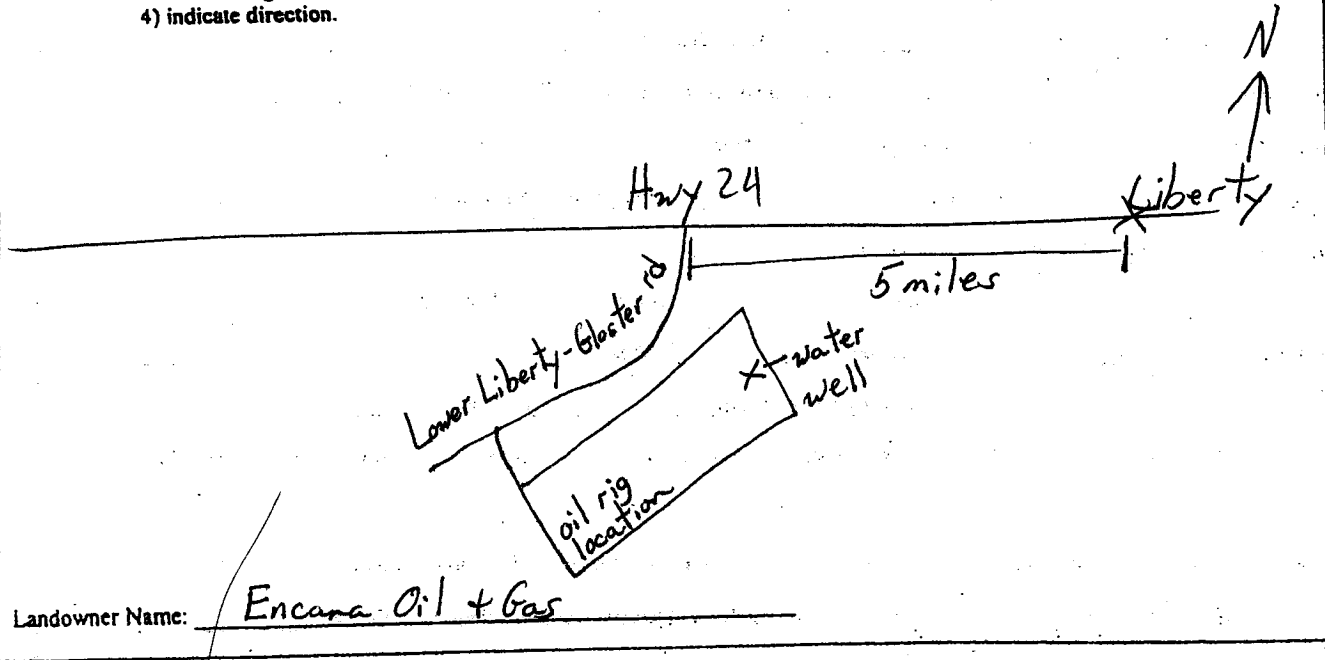

John Thompson
Signature of Water Well Contractor

M101

STATE WELL REPORT

Part 2

Pump Installer's Completion Report
Mississippi Department of Environmental Quality
Office of Land and Water Resources
P.O. Box 10631
Jackson, MS 39289-0631
(601)961-5210
(601)354-6938 (fax)

County: Amite
 Permit #: _____
 Driller: John W Thompson
 Date completed: 3-31-12
Copy information from block on Part 1

For Office Use Only:
 Aquifer: _____
 Well #: M101
 Elevation: _____

This part of the report must be completed by a licensed water well contractor or a licensed pump installer. A copy of Part 1 of the report must be attached and both parts filed with the Department at the above address within 30 days of well completion.

Well Owner Information	Well Location
Owner Name: <u>Encana Oil & Gas</u>	Latitude: <u>31°10'17"</u> Longitude: <u>90°54'36"</u>
Mailing Address: <u>RT 2 Box 2462 Hwy 786</u> <u>P.O. Box 1457</u> <u>Coushatta LA 71019</u> City State Zip Code	Method of Lat/Long (check one): Conventional Survey _____ USGS quad _____, Hand-held GPS <input checked="" type="checkbox"/> , Survey-grade GPS _____ _____ 1/4 _____ 1/4 Sec <u>4</u> T <u>2N</u> R <u>3E</u>
Telephone No. () _____	Distance Direction Nearest Town <u>6</u> Miles <u>W</u> of <u>Liberty</u>

Pump Type Circle one	Power Type Circle one
Air Lift Jet <input type="checkbox"/> <u>Submersible</u>	Diesel Engine Gasoline Engine Natural Gas
Bucket Piston Turbine	<u>Electric Motor</u> Hand Tractor PTO
Centrifugal Rotary Flowing Well	Windmill Other (specify): _____
Other (specify): _____	Horse Power Rating of Motor: <u>7.5</u>
Date Pump Installed: <u>4-3-12</u>	Setting Depth: <u>240</u> feet
Rated Pump Capacity: <u>55</u> Gallons Per Minute	Number of Stages: _____

Pump Test Data	Method of Measuring Water Level Circle one
Date Well Tested: <u>3-31-12</u>	<u>Air Line</u> Electric Measuring Line Steel Tape
Static Water Level (A): <u>194</u> Feet Below Land Surface	Other (specify): _____
Pumping Water Level (B): <u>200</u> Feet Below Land Surface	For flowing well, measured shut in head: _____ feet
Drawdown [(B) - (A)]: <u>6</u> Feet Below Land Surface	Well yielded <u>50</u> GPM with a drawdown of
Test Pumping Rate: <u>50</u> Gallons Per Minute	<u>6</u> feet after <u>4</u> hours of pumping
Duration of Pump Test (minimum 4 hours): <u>4</u> hours	

I HEREBY CERTIFY that the above statements are true to the best of my knowledge.

John W Thompson 0-679 John W Thompson
 Print Name of Pump Installer and License No. (if applicable) Signature of Pump Installer

Form: OLWR-SWR-18

RECEIVED

APR 09 2012

BY: OLWR