

MISSISSIPPI DEPARTMENT OF ENVIRONMENTAL QUALITY
Bureau of Land and Water Resources

P. O. Box 10631
Jackson, MS 39289-0631
WATER WELL DRILLERS LOG

COUNTY WELL LOCATED Amite		PERMIT NUMBER 453
WELL NUMBER Robertson	CODED	NAME OF DRILLING FIRM Morphis Brothers
#3 M 2049		Trout, La 71371
DATE WELL COMPLETED 10/11/93		

NAME & MAILING ADDRESS OF LANDOWNER Seagull-Mid South		
P.O. Box 20116		
Shreveport, La 71120-0116		
WELL LOCATION: SEC	TOWNSHIP	RANGE
35	2 ^N _S	3 ^E _W
DISTANCE 8 Miles	DIRECTION 5	NEAREST TOWN Centreville
OTHER LANDMARK Berwick Baptist Church		
WELL PURPOSE: Home, Irrigation, Municipal, Industrial, Fish Pond, etc. Rig Supply		

PUMP DATA		
PUMP TYPE (Circle One): <input checked="" type="checkbox"/> Submersible, <input type="checkbox"/> Turbine, <input type="checkbox"/> Jet, <input type="checkbox"/> Flowing Well, Other (Describe) _____		
POWER TYPE (Circle One): <input checked="" type="checkbox"/> Electric, <input type="checkbox"/> Tractor, <input type="checkbox"/> Diesel, <input type="checkbox"/> Gasoline, <input type="checkbox"/> Butane, Other (Describe) _____ H/P _____		
Pump Capacity (GPM)	No. of Stages	Setting Depth FT.
PUMP TEST		
Well yielded 90 GPM with a drawdown of NA ft. after _____ hours of pumping		

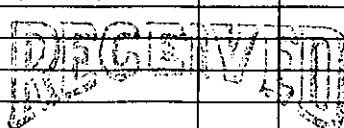
WELL DATA		
Well Depth 240	Casing Diameter (In.) 4	Casing Length (Ft.) 222
Type of Casing PVC	Hole Depth 240	Depth to Static Water Level —
TYPE OF COMPLETION: (Circle One or More): <input checked="" type="checkbox"/> Gravel Packed, <input type="checkbox"/> Underreamed, <input type="checkbox"/> Telescoped, <input type="checkbox"/> Natural Development, <input type="checkbox"/> Open Hole, <input type="checkbox"/> Other (Describe) _____		
Top of Lap Pipe or Reduction in Casing FEET IF TELESOPED OR MORE THAN ONE SCREEN: USE BACK PAGE		

LOG DATA	
TYPE OF LOG RUN (Circle One): <input type="checkbox"/> No Log Run, <input type="checkbox"/> Electric, <input type="checkbox"/> Gamma Ray, <input type="checkbox"/> Density, <input type="checkbox"/> Sonic, <input type="checkbox"/> Neutron, Other (Describe) _____	
Name of Organization Running Log	

SCREEN DATA		
Diameter - Inches 4	Length - Feet 20	Slot Size - Inches .020
Screen Type PVC	Depth to Bottom - Feet 0	

GEOLOGIC DATA (Office Use Only)			
Surface Elev.	Geologic Unit	Unit Thickness	Depth to Top
Subs. SWL	Date	Analysis	Aquifer Test

Driller's Remarks

DESCRIPTION OF FORMATIONS ENCOUNTERED	FROM	TO	FORMATIONS (Continued)	FROM	TO
Yellow & Red Silty Clay	0	15	 NOV 15 1993 Dept. of Environmental Quality Office of Land & Water Resources		
Yellow Sand & Gravel	15	60			
Yellow Clay & Gravel	60	80			
Yellow Clay	80	100			
Yellow Sandy Clay	100	185			
Red & Yellow Med Sand	185	220			
Coarse Wh. Sand w/ small gravel	220	240			
IF MORE SPACE IS NEEDED, USE BACK					