

AMITE MISSISSIPPI BOARD OF WATER COMMISSIONERS

N⁹
2-11-61

WATER WELL DRILLERS LOG

N 300
CODED

Date: 2-11, 1961, Driller: Chester Reeves County Amite
(Name)

(1) Owner of Land: E.T. Rice
(Name)
Liberty, Miss.
(Address)

(2) Location: 1/4, 1/4, Sec. 10 T2R4
1/2 miles EAST of Liberty
(distance) (direction) (Nearest Town)

(3) Topography: Hilly
(Hilly) (Flat) (Level)

(4) Purpose of Well: Domestic
(Domestic Irrigation
Municipal, Industrial, Other)

Description & Color of Materials Sand, Clay, Red Clay, Shell, etc.	Thick- ness Feet	Depth Feet
Red clay	15	15
Red sand & gravel	52	67
Red chalk & sand	23	90
Small gravel & sand	17	99


Information upon completion of well:

- (1) Diameter 2 inches.
- (2) Total Depth 99 feet.
- (3) Water Level 82 feet below top of ground.
- (4) Cased to Bottom, Size 2"
- (5) Screen: Size 1 1/4", Length 6'
- (6) Were any formations sealed against pollution?
yes, no.

If YES depth of formation _____

Why _____

Drillers Remarks:
HAD 2 previous old wells.

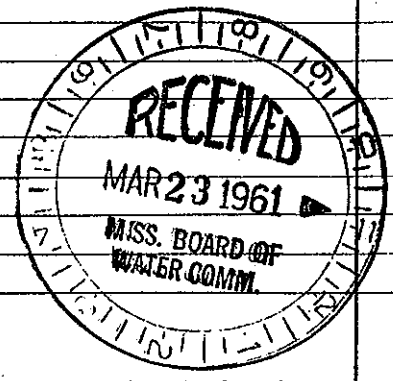

(Use Back Side)

Well No.

Mail this copy to Board of Water Commissioners 429 Miss. St. Jackson, Miss