

AMITE MISSISSIPPI BOARD OF WATER COMMISSIONERS

N 11

7-22-64 WATER WELL DRILLERS LOG

CODED

Date: 7-22, 1964, Driller: Chester Keene County Amite

(Name)

(1) Owner of Land:	Description & Color of Materials Sand, Clay, Red Clay, Shell, etc.	Thick- ness Feet	Depth Feet
<u>W. C. Blalock</u> <u>Liberty</u>	<u>Red clay</u>	<u>20</u>	<u>20</u>
	<u>Red sand</u>	<u>10</u>	<u>90</u>
(2) Location: <u>1/4</u> , <u>1/4</u> , Sec. <u>15</u> T <u>4</u> R <u>4</u>	<u>cherty gravel</u>	<u>10</u>	<u>100</u>
<u>2 1/2</u> miles <u>S.E.</u> of <u>Liberty</u>	<u>sandy chalk</u>	<u>5</u>	<u>105</u>
(3) Topography: <u>Hilly</u>	<u>fine gravel & gravel</u>	<u>21</u>	<u>126</u>
(4) Purpose of Well: <u>Domestic</u>			


Information upon completion of well:

- (1) Diameter 4 inches.
- (2) Total Depth 126 feet.
- (3) Water Level 85 feet below top of ground.
- (4) Cased to Bottom size 4"
- (5) Screen: Size 4", Length 7'
- (6) Were any formations sealed against pollution?
 yes, no.

If YES depth of formation _____

Why _____

Drillers Remarks: new house

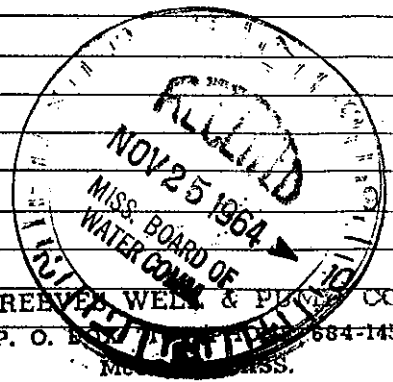

(Use Back Side)

Well No.

Mail this copy to Board of Water Commissioners 429 Miss. St. Jackson, Miss.