

AMITE MISSISSIPPI BOARD OF WATER COMMISSIONERS

N 13

8-26-64 WATER WELL DRILLERS LOG

CODED

Date: 8-26, 1964, Driller: Chester Reeves County Amite

(Name)

(1) Owner of Land	Description & Color of Materials Sand, Clay, Red Clay, Shell, etc.	Thick- ness Feet	Depth Feet
J. Lilly	Red Clay	20	20
RFD - Liberty	Red sand	40	60
(Address)	Small gravel	27	87
(2) Location: 1/4, 1/4, Sec. 15 T. 2 R. 4	Brown		
2 1/2 miles S. of Liberty	Blue shale	143	230
(distance) (direction) (Nearest Town)	Coarse sand	20	250
(3) Topography: Lilly			
(Hilly) (Flat) (Level)			
(4) Purpose of Well: Domestic			
(Domestic Irrigation Municipal, Industrial, Other)			

Information upon completion of well:

(1) Diameter 4 inches.

(2) Total Depth 250 feet.

(3) Water Level 65 feet below top of ground.

(4) Cased to bottom size 4"


(5) Screen: Size 4", Length 7'

(6) Were any formations sealed against pollution?  
 \_\_\_\_\_ yes,  no.

If YES depth of formation \_\_\_\_\_

Why \_\_\_\_\_

Drillers Remarks red well went bad.

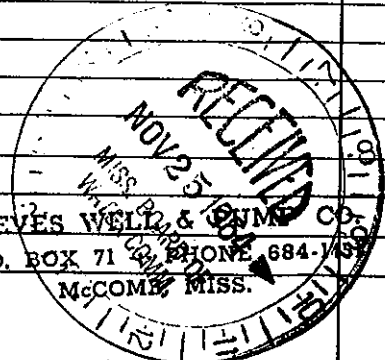

(Use Back Side)

Well No.

Mail this copy to Board of Water Commissioners 429 Miss. St. Jackson, Miss.