

AMITE MISSISSIPPI BOARD OF WATER COMMISSIONERS

N14  
 9-11-64 220 WATER WELL DRILLERS LOG

**CODED**

Date: Sept 11, 1964, Driller: Chester Reeves County Amite  
 (Name)

(1) Owner of Land:	Description & Color of Materials (Sand, Clay, Red Clay, Shell, etc.)	Thick- ness Foot	Depth Foot
Temple Lee C. Lee P.O. - Liberty (Address)	Red clay	20	20
	Red sand	45	65
(2) Location: 1/4, 1/4, Sec. 5 T. 2 R. 7	Gravel	15	80
	White chert	8	88
1/2 miles N.W. of Liberty (Distance) (direction) (Nearest Town)	gravel sand	7	95
	Red clay	35	130
(3) Topography: Hilly (Hilly) (Flat) (Level)	Coarse white sand	27	157
(4) Purpose of Well: Domestic (Domestic Irrigation Municipal, Industrial, Other)			

**CODED**

Information upon completion of well:

(1) Diameter 4 inches.

(2) Total Depth 157 feet.

(3) Water Level 92 feet below top of ground.

(4) Cased to Bottom Size 4"


(5) Screen: Size 4", Length 7'

(6) Were any formations sealed against pollution?  
 \_\_\_\_\_ yes,  no.

If YES depth of formation \_\_\_\_\_

Why \_\_\_\_\_

Drillers Remarks: New house

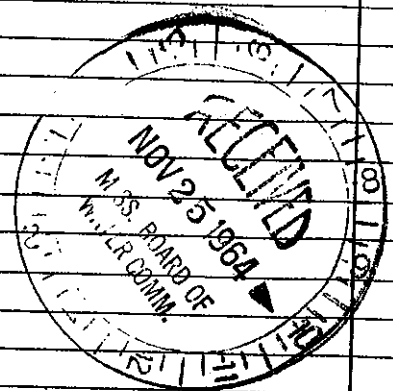

REEVES WELL & PUMP CO.  
 P. O. BOX 71 -- PHONE 684-1451  
 McCOMB, MISS.

Well No.

(Use Back Side)  
 Mail this copy to Board of Water Commissioners 429 Miss. St. Jackson, Miss.