

ANITE MISSISSIPPI BOARD OF WATER COMMISSIONERS

N15


6-26-65

WATER WELL DRILLERS LOG

CODED

Date: 6-26, 1965, Driller: J.T. Covington County: Pike  
 (Name)

(1) Owner of Land: <u>Mrs. Clayton</u> <u>Whittington</u> <u>Liberty, Miss</u> (Address)	Description & Color of Materials Sand, Clay, Red Clay, Shell, etc.	Thick- ness Feet	Depth Feet
(2) Location: $\frac{1}{4}$ , $\frac{1}{4}$ , Sec. <u>8</u> T <u>2R</u> <u>4</u> , <u>1</u> miles <u>west</u> , of <u>Liberty</u> (distance) (direction) (Nearest Town)			
(3) Topography: <input checked="" type="checkbox"/> (Hilly) <input type="checkbox"/> (Flat) <input type="checkbox"/> (Level)			
(4) Purpose of Well: <u>Domestic</u> (Domestic Irrigation Municipal, Industrial, Other)			
Information upon completion of well:			
(1) Diameter <u>4</u> inches.			
(2) Total Depth <u>107</u> feet.			
(3) Water Level <u>50</u> feet below top of ground.			
(4) Cased to <u>107</u> , Size <u>4"</u>			
(5) Screen: Size <u>10</u> , Length <u>6"</u>			
(6) Were any formations sealed against pollution? _____ yes, <input checked="" type="checkbox"/> no.			
If YES depth of formation _____			
Why _____			
Drillers Remarks: _____			

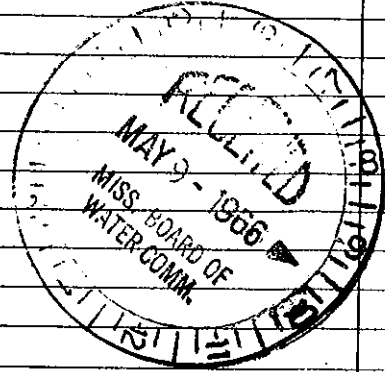

Well No.

(Use Back Side)

Mail this copy to Board of Water Commissioners 429 Miss. St. Jackson, Miss.