

Amite
N17
8-66

MISSISSIPPI BOARD OF WATER COMMISSIONERS

CODED

WATER WELL DRILLERS LOG

Date: Aug 16, 1966 Driller: Reverwell Pump Co. County: Amite
(When well drilled) (Name) (Where well is located)

(1) Owner of Land: William Kirkland Jr.
Liberty, Miss
(Name) (Address)
(2) Location: 1/4, 1/4, Sec 10 T2R4
2 miles SE of Liberty
(distance) (direction) (Nearest Town)
(3) Topography: Hilly
(Hilly) (Flat) (Level)
(4) Purpose of Well: Domestic
(Domestic Irrigation
Municipal, Industrial, Other)

Description & Color of Materials Sand, Clay, Red Clay, Shell, etc.	Thick- ness Feet	Depth Feet
Red clay	25	25
Red sand	35	60
Clayey sand & gravel	25	85
Red chalk	5	90
gravel	10	100
Red & white chalk	35	135
Coarse sand and fine gravel	15	150


Information upon completion of well:

(1) Diameter 4" inches.
(2) Total Depth 150 feet.
(3) Water Level 95 feet below top of ground.
(4) Cased to bottom Size 4"
(5) Screen: Size 4", Length 6'
(6) Were any formations sealed against pollution?
_____ yes, no.

If YES depth of formation _____

Why _____

Drillers Remarks: _____
Yield in gpm: 15
Size pump: 1 1/2" jet pump
Type power: Electric

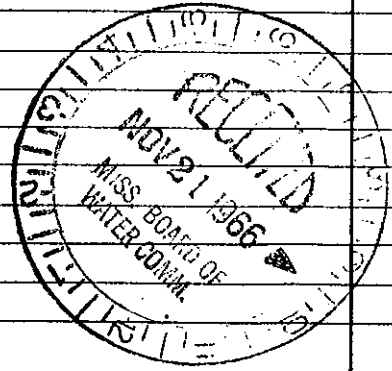

Mail this copy to Board of Water Commissioners 429 Miss. St. Jackson, Miss.