

Amite
N18
10-66

MISSISSIPPI BOARD OF WATER COMMISSIONERS

CODED
CODED

WATER WELL DRILLERS LOG

Date: 10-5, 1966 Driller: Alc Fitzgerald County Amite
(When well drilled) (Name) (Where well is located)

1) Owner of Land: Howard Bates
(Name)
Liberty Rt
(Address)

2) Location: NW 1/4, NW 1/4, Sec. 46 T 2 R 7
4 miles South of Liberty
(distance) (direction) (Nearest Town)

3) Topography: X
(Hilly) (Flat) (Level)

4) Purpose of Well: Domestic
(Domestic Irrigation
Municipal, Industrial, Other)

Description & Color of Materials Sand, Clay, Red Clay, Shell, etc.	Thick- ness Feet	Depth Feet
		0
Red clay + gravel	15	15
Red sand	45	60
Heavy gravel	20	80
Fine Red sand	10	90
Gravel + coarse sand	10	100

Information upon completion of well:

1) Diameter 4 inches.

2) Total Depth 102 feet.

3) Water Level 80 feet below top of ground.

4) Cased to 94, Size 4"

5) Screen: Size 4", Length 8'

6) Were any formations sealed against pollution?
 _____ yes, X no.

YES depth of formation _____


hy _____

Drillers Remarks: _____

Yield in gpm: 20 gpm

Size pump: Bucket

Type power: _____

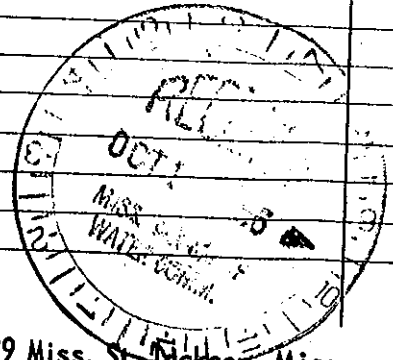

File this copy to Board of Water Commissioners 429 Miss. St. Jackson, Miss.