

Amite
N 19
11-66

MISSISSIPPI BOARD OF WATER COMMISSIONERS

WATER WELL DRILLERS LOG

CODED

Date: 16 Nov, 1966, Driller: J. L. Covington, County Amite
(Name)

(1) Owner of Land: <u>H.C. Hawkins</u> (Name)	Description & Color of Materials Sand, Clay, Red Clay, Shell, etc.	Thick- ness Feet	Depth Feet
<u>Liberty</u> (Address)	<u>clay</u>	<u>40</u>	<u>40</u>
(2) Location <u>NE 1/4, SW 1/4, Sec. 3 T2R4</u>	<u>chalk sand</u>	<u>40</u>	<u>80</u>
<u>3</u> miles <u>East</u> , of <u>Liberty</u> (distance) (direction) (Nearest Town)	<u>chalk</u>	<u>120</u>	<u>120</u>
(3) Topography: <input checked="" type="checkbox"/> (Hilly) <input type="checkbox"/> (Flat) <input type="checkbox"/> (Level)	<u>sand</u>	<u>31</u>	<u>151</u>
(4) Purpose of Well: <u>Domestic</u> (Domestic Irrigation Municipal, Industrial, Other)			


Information upon completion of well:

- (1) Diameter 4 inches.
- (2) Total Depth 151 feet.
- (3) Water Level 80 feet below top of ground.
- (4) Cased to 151', Size 4"
- (5) Screen: Size 4', Length 12'
- (6) Were any formations sealed against pollution?
_____ yes, no.

If YES depth of formation _____

Why _____

Drillers Remarks: _____

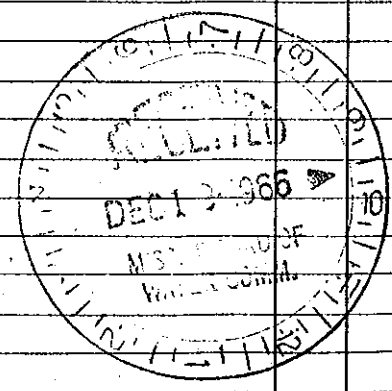

(Use Back Side)

Well No.

Mail this copy to Board of Water Commissioners 429 Miss. St. Jackson, Miss