

Amite
N22
8-67

MISSISSIPPI
BOARD OF WATER COMMISSIONERS CODED
416 North State Street
Jackson, Mississippi 39201

WATER WELL DRILLERS LOG

8-5 1967 67 Fitzgerald W/Ws Amite
date well completed firm name county well located


LANDOWNER A. B. Beatt
Liberty, Miss
(mailing address)

description of formations encountered	from	to
top soft clay	0	18
sand	18	45
heavy gravel	45	70
red chalk	70	85
gravel sand	85	112
chalk white	112	

WELL LOCATION:
sec. 3 T 2 N R 4 E
S W
1 miles E of Liberty
(distance) (direction) (nearest town)

WELL PURPOSE: home
(home, irrigation, municipal, industrial)

- WELL COMPLETION DATA:
- (1) diameter (inches) 4
 - (2) total depth (feet) 110
 - (3) static water level (feet) 80 below top of ground.
 - (4) casing plastic 104
(material) (depth)
 - 4 If telescope see back.
(size)
 - (5) screen 6' 104
(length) (depth to top)
 - 4" plastic
(size) (material)
 - (6) pump 1/2 12
(hp) (yield gpm)
 - elec.
(type power)
 - (7) electric log No
(yes or no)
 - (organization running log)
 - (8) how well bottom plugged Wood peg

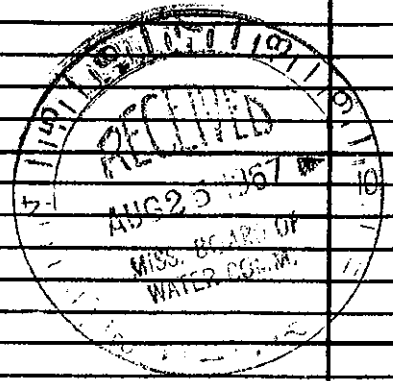

DRILLERS REMARKS: