

Amite
N25
11-67

MISSISSIPPI
BOARD OF WATER COMMISSIONERS
416 North State Street
Jackson, Mississippi 39201

CODED

WATER WELL DRILLERS LOG

11-2 1967 Fitzgerald Water Well Amite
date well completed firm name county well located


LANDOWNER: George Faust
Liberty 4 Rd Miss
(mailing address)

description of formations encountered	from	to
Red clay	0	70
gray clay	70	116
Red clay	116	116
Chase Sand & gravel	18	12

WELL LOCATION:
sec 25 T 2 N R 4 E
S W
2 miles 50 of Liberty
(distance) (direction) (nearest town)

WELL PURPOSE: Farm
(home, irrigation, municipal, industrial)

- WELL COMPLETION DATA:
- (1) diameter (inches) 4
 - (2) total depth (feet) 125
 - (3) static water level (feet) 100 below top of ground.
 - (4) casing plastic 119 (material) (depth)
4 (size) If telescope see back.
 - (5) screen 6' 119 (length) (depth to top)
4 plastic (size) (material)
 - (6) pump (HP) (yield gpm)
(type power)
 - (7) electric log NO (yes or no)
(organization running log)
 - (8) how well bottom plugged Wood peg

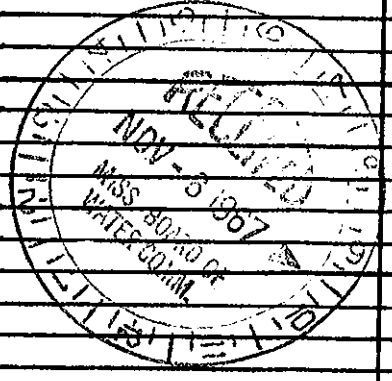

DRILLERS REMARKS: