

AMITE MISSISSIPPI BOARD OF WATER COMMISSIONERS

N27
1-20-64

145

WATER WELL DRILLERS LOG

CODED

Date: Jan 20, 1964, Driller: Christie Lewis county Amite
(Name)

(1) Owner of Land: Mahony Lumber
(Name)
Liberty
(Address)

(2) Location: 1/4, 1/4, Sec. 2 T2R4
1 miles East of Liberty
(distance) (direction) (Nearest Town)

(3) Topography: Hilly
(Hilly) (Flat) (Level)

(4) Purpose of Well: Sawmill
(Domestic Irrigation
Municipal, Industrial, Other)

Description & Color of Materials Sand, Clay, Red Clay, Shell, etc.	Thick- ness Feet	De p th
<u>Red Clay</u>	<u>30-30</u>	
<u>Red sand & gravel</u>	<u>60-90</u>	
<u>white chalk</u>	<u>20-110</u>	
<u>Sand & gravel</u>	<u>10-120</u>	

Information upon completion of well:


- (1) Diameter 4 inches.
- (2) Total Depth 120 feet.
- (3) Water Level 100 feet below top of ground.
- (4) Cased to bottom size.
- (5) Screen: Size 4, Length 6'
- (6) Were any formations sealed against pollution?
_____ yes, no.

If YES depth of formation _____

Why _____

Drillers Remarks: old well
insufficient

CODED

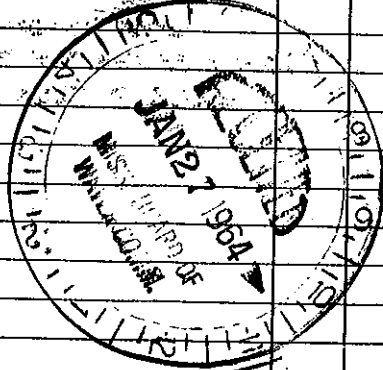

BEEVES WELL & PUMP CO.
P. O. BOX 71 - PHONE 684-1461
McCOMB, MISS.

(Use Back Side)

Mail this copy to Board of Water Commissioners 429 Miss. St. Jackson, Miss.

Well No.