

Amite N28
 2-1-62
 Date: 2-1-1962, Driller: Chester Reeves, County: Amite

MISSISSIPPI BOARD OF WATER COMMISSIONERS

1180, 1247

WATER WELL DRILLERS LOG

CODED

(1) Owner of Land	Description & Color of Materials	Thickness Feet
Lucius Morgan Liberty	Red clay 0-20	20
	Red sand 20-60	60
	sand & gravel 60-84	4
	white chalk 84-120	36
	Fine Pink Sand 120-200	80
	Coarse Sand 200-214	14

(2) Location: 1/4, 1/4, Sec. 9 T2R9
 2 miles East of Liberty
 (distance) (direction) (Nearest Town)
 (3) Topography: Hilly
 (Hilly) (Flat) (Level)
 (4) Purpose of Well: Domestic
 (Domestic Irrigation, Municipal, Industrial, Other)


Information upon completion of well:

(1) Diameter 2 inches.
 (2) Total Depth 214 feet.
 (3) Water Level 94 feet below top of ground.
 (4) Cased to bottom size 2"
 (5) Screen: Size 1 1/4, Length 6'
 (6) Were any formations sealed against pollution?
 yes, no.

If YES depth of formation _____
 Why _____

Drillers Remarks:
 New House

CODED

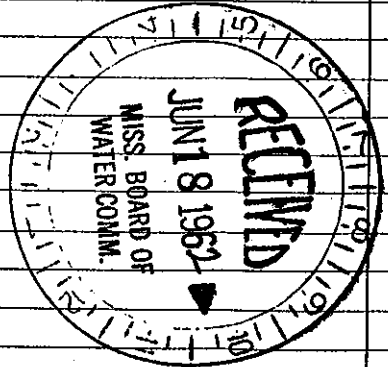

(Use Back Side)

Mail this copy to Board of Water Commissioners 429 Miss. St. Jackson.