

AMITE MISSISSIPPI BOARD OF WATER COMMISSIONERS

N29

5-16-63

WATER WELL DRILLERS LOG

CODED

Date: 5-16, 1963, Driller: Chester Reeves County Amite

(1) Owner of Land: W. C. Liberty
(Name)
Liberty
(Address)

(2) Location: 1/4, 1/4, Sec. T, R
2 miles East of Liberty
(distance) (direction) (Nearest Town)

(3) Topography: Hilly
(Hilly) (Flat) (Level)

(4) Purpose of Well: Domestic
(Domestic Irrigation Municipal, Industrial, Other)

Description & Color of Materials Sand, Clay, Red Clay, Shell, etc.	Thick- ness Feet	Dr P
clay	20	20
Red Sand	60	80
Sand & gravel	10	90
white chalk	2	92
Small gravel	8	100

Information upon completion of well:


- (1) Diameter 4 inches.
- (2) Total Depth 100 feet.
- (3) Water Level 90 feet below top of ground.
- (4) Cased to bottom, size 4
- (5) Screen: Size 4", Length 4'
- (6) Were any formations sealed against pollution?
 yes, no.

If YES depth of formation _____

Why _____

Drillers Remarks: old well
insufficient

REEVES WELL & PUMP CO.
P. O. BOX 71 -- PHONE 804-1451

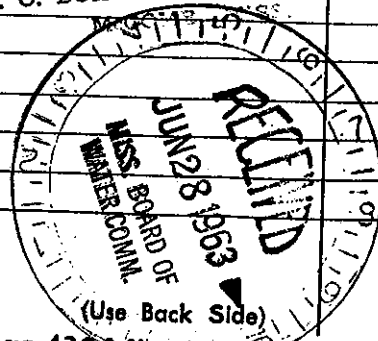

Well No.

Mail this copy to Board of Water Commissioners 429 Miss. St. Jackson, Miss