

AMITE MISSISSIPPI BOARD OF WATER COMMISSIONERS

N 30

152

CODED

5-5-64

WATER WELL DRILLERS LOG

Date: 5-5, 1964, Driller: Chester Reeves County Amite

(Name)

(1) Owner of Land	Description & Color of Materials Sand, Clay, Red Clay, Shell, etc.	Thick- ness Foot	Depth Feet
<u>Chas. Kirkland</u> (Name)	<u>Surface clay</u>	<u>20</u>	<u>20</u>
<u>Liberty</u> (Address)	<u>Red sand & gravel</u>	<u>75</u>	<u>95</u>
(2) Location: <u>1/4</u> , <u>1/4</u> , Sec. <u>2</u> T. <u>2</u> R. <u>9</u>	<u>Gravel</u>	<u>22</u>	<u>117</u>
<u>2</u> miles <u>EAST</u> , of <u>Liberty</u> (distance) (direction) (Nearest Town)	<u>Sand & gravel</u>	<u>11</u>	<u>128</u>
(3) Topography: <u>Hilly</u> (Hilly) (Flat) (Level)			
(4) Purpose of Well: <u>Domestic</u> (Domestic Irrigation Municipal, Industrial, Other)			

CODED


Information upon completion of well:

- (1) Diameter 4 inches.
- (2) Total Depth 128 feet.
- (3) Water Level 95 feet below top of ground.
- (4) Cased to Bottom, Size 4"
- (5) Screen: Size 4", Length 7'
- (6) Were any formations sealed against pollution?
no.

If YES depth of formation _____

Why _____

Drillers Remarks: Edwell
Dry.

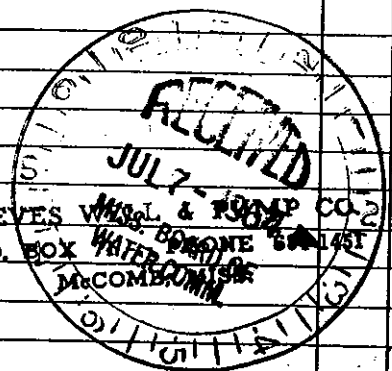

Well No.

(Use Back Side)

Mail this copy to Board of Water Commissioners 429 Miss. St. Jackson, Miss