

AMITE MISSISSIPPI BOARD OF WATER COMMISSIONERS

N31

238

5-29-64

WATER WELL DRILLERS LOG

CODED

Date: 5-29, 1964, Driller: Chester Reeves County Amite

(Name)

(1) Owner of Land	Description & Color of Materials (Sand, Clay, Red Clay, Shell) etc.	Thick- ness Feet	Depth Feet
(Name) <u>Willie Bartley</u>	<u>Surface clay</u>	<u>50</u>	<u>20</u>
(Address) <u>Liberty</u>	<u>yellow sand</u>	<u>50</u>	<u>70</u>
(2) Location: <u>1/4</u> , <u>1/4</u> , Sec. <u>5 T2 R4</u>	<u>Sand & gravel</u>	<u>11</u>	<u>81</u>
(distance) <u>1</u> miles <u>west</u> of <u>Liberty</u>			
(direction) (Nearest Town)			
(3) Topography: <u>Hilly</u>			
(Hilly) (Flat) (Level)			
(4) Purpose of Well: <u>Domestic</u>			
(Domestic Irrigation Municipal, Industrial, Other)			

CODED

Information upon completion of well:


- (1) Diameter 4 inches.
- (2) Total Depth 81 feet.
- (3) Water Level 53 feet below top of ground.
- (4) Cased to Bottom Size 4"
- (5) Screen: Size 4", Length 7'
- (6) Were any formations sealed against pollution?
 yes, no.

If YES depth of formation _____

Why _____

Drillers Remarks: old well
sanded

REEVES WELL DRILLING CO.
P. O. BOX 71 PHONE 441-155
McCOMB, MISS.

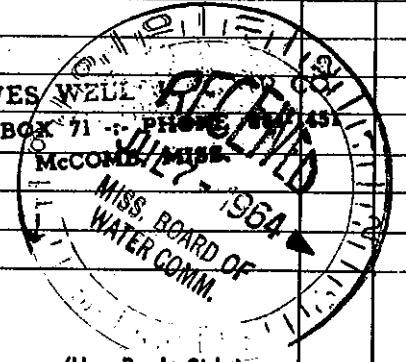

(Use Back Side)

Well No.

Mail this copy to Board of Water Commissioners 429 Miss. St. Jackson, Miss.