

AMITE  
N70  
8-13-65

423 1074

MISSISSIPPI BOARD OF WATER COMMISSIONERS

WATER WELL DRILLERS LOG

**CODED**

Date: 8-13, 1965, Driller: Chester Keener County amite  
(Name)

		Description & Color of Materials Sand, Clay, Red Clay, Shell, etc.	Thick- ness Feet	Depth Feet
(1) Owner of Land: <u>W.C. Baggett</u> (Name) <u>RFD, Liberty</u> (Address)		<u>Red top clay</u>	<u>20</u>	<u>2.0</u>
		<u>Red sand</u>	<u>15</u>	<u>3.5</u>
		<u>Red chalk</u>	<u>55</u>	<u>9.0</u>
(2) Location: <u>30</u> <u>T</u> <u>2</u> <u>R</u> <u>4</u> Sec. <u>30</u> T <u>2</u> R <u>4</u>		<u>Sandy sand</u>	<u>44</u>	<u>13.4</u>
<u>7</u> miles <u>SW</u> of <u>Liberty</u> (distance) (direction) (Nearest Town)		<u>Sand</u>	<u>15</u>	<u>14.9</u>
(3) Topography: <u>Hilly</u> (Hilly) (Flat) (Level)				
(4) Purpose of Well: <u>Domestic</u> (Domestic Irrigation Municipal, Industrial, Other)				

Information upon completion of well:


- (1) Diameter 4 inches.
- (2) Total Depth 149 feet.
- (3) Water Level 90 feet below top of ground.
- (4) Cased to Bottom Size 4"
- (5) Screen: Size 4", Length 7'
- (6) Were any formations sealed against pollution?  
\_\_\_\_\_ yes, X no.

If YES depth of formation \_\_\_\_\_

Why \_\_\_\_\_

Drillers Remarks: good well  
Ball

**CODED**

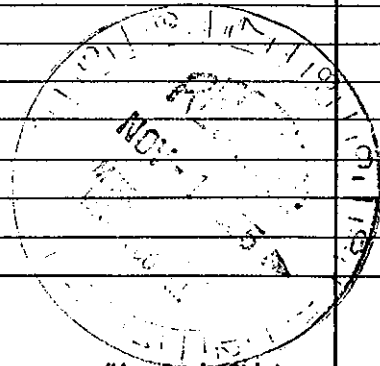

(Use Back Side)

Well No.

Mail this copy to Board of Water Commissioners 429 Miss. St. Jackson, Miss.