

AMITE
N 103
10/21/74

MISSISSIPPI
BOARD OF WATER COMMISSIONERS
416 North State Street
Jackson, Mississippi 39201

CODED

WATER WELL DRILLERS LOG

Oct 21 1974 date well completed
J. Chesters firm name
Amite county well located

LANDOWNER: J. Chesters
RFD Liberty

(mailing address)

WELL LOCATION:

sec. 5 T. 2 N. R. 4 E
1 miles NW Liberty
(distance) (direction) (nearest town)

WELL PURPOSE: Domestic
(home, irrigation, municipal, industrial)

WELL COMPLETION DATA:

- (1) diameter (inches) 4"
- (2) total depth (feet) 106
- (3) static water level (feet) 71 below top of ground
- (4) casing Plast. Bottom (material) (depth)
- (size) If telescope see back.
- (5) screen 6' 9.5' (length) (depth to top)
- (size) (material) 4" Plast.
- (6) pump 1/2 HP 12 (HP) (yield gpm)
- (type power) Elect.
- (7) electric log NO (yes or no)


(organization running log)

(8) how well bottom plugged
water plug

DRILLERS REMARKS:
New house

description of formations encountered	from	to
clay	0	12
Red Sand	20	90
Sand & gravel	90	101

CODED

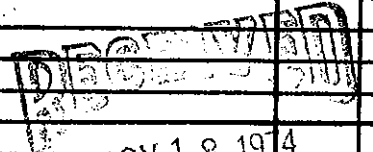

NOV 18 1974

BD. OF WATER COMM