7	-	_
4	1	
1	1	

County:	Amite
Permit #	#: _n/A
Driller:	W2 0-808
	lling completed: 9/27/21

Well Owner Information

STATE WELL REPORT

Part 1

Driller's Log
Mississippi Department of Environmental Quality
Office of Land and Water Resources P.O. Box 2309

Jackson, MS 39225-2309 (601)961-5555

(601)961-5228 (fax)

For	Office Use Only:
Well #:	
Aquifer	
E-Log #:	

State Law requires that this report be prepared by the license holder responsible for the work and filed with the Department at the above address within 30 days of completion of drilling of the well or borehole.

Well Owner Information (Landowner if borehole is not for a water well)	Well or Borehole Location Latitude: 31 9 36.14 Longitude: 90 50 15.17
Owner Name: Scenic Fivers	
Mailing Address: 1068 Dog wood Trail	Method of Lat/Long (check one): Conventional Survey,
	USGS quad, Hand-held GPS, Survey-grade GPS
mcComb ms 39648	SE 4 SE 4, Sec 6 T ZN R 4E
City State Zip Code	1.58 Miles W of Liberty, ms.
Telephone No. (601) 684 - 9568	(Distance) (Direction) (Nearest Town)
Date drilling started: 7/13/21 Date drilling completed: Location of the source of any surface water used for drilling.	
Method of dosing and volume of Chlorine used in drilling a	and development: Public Supply
Logs run (check all applicable): log run Electric Lann	ma Ray Dens ty Sonic Neutron Other:
Name of organization running log(s): nDfa Geolog	y Dept.
	ical/Geologica: Investigation Ground Source Heat Pump (describe) onstruction, skip the remainder of this block
Purpose of Well (check all applicable): Home industria	4 1 1 1
Other (describe):	Tublic Supply Irrigation Fish Culture RECT 1021
If a flowing well, method of flow regulation: Valve	00: 43
Static Water Level: 60 feet above or belo (check one)	
Method of measurement (check one) Steel tape Electric	tape DAir line Bother (describe): Soni C
Well depth: 700' Well grouted to a depth of: 160' for	Type of grout (check one) Neat Cement Bentonite Mix
Casing length: 170' feet Casing diameter: 4	inches Type of casing: Sch 40 PVC
Screen length: 36 feet Screen diameter:	inches Type of screen: 70' of 5.5 wire wire
Screen slot size: 23' fram Issht inches Setting depth:	From 170 feet to 700 feet
Type of completion (check all applicable) ravel packed	Underreamed Open hole Natural Development
Other (describe):	
Top of lap pipe or reduction in casing:feet	ne screen, describe on next page
A telescoped of more into	ne screen, aescribe on next page

Permit #:			Well #:	
The sketch below only re		Description of formations encou and boreholes, unless specifical	untered must be provid lly exempted by regular	led for all well.
If well telescopes, show a				
Ground Level	1 11	Description of Formations Encount	ered From (depth) Ground level	To (depth)
		sand rock		18
1	1 170	yellow Clay	18	56
		Jany & per gravel	76	80
	Sch 4a	white clay medisans	80	100
1/2	Sin Ha 4" puc	West Sava	100	Zuo
Benjarite	(4120)	5-ft pink clay	2.0	214
Control	(037.)			
185.	Control of the Contro		7 (S. 10) S.	
2,001				
				a some supplied the
				-
1.	_ ↓			
	1 12, of 0015 br			
	21-4 35-40.			
	1 20' of			
	72° of			
	Y CCWIEVIN			
If more than one screen, show	v location of each on sketch			1
3) any roads, power lines, 4) north arrow	res on the property that may aid or other items that may aid in lo	ocating the property and the well		
			REC	CEIVET 17 25 2029 1 OLW
				WIO
			B	100
_	-			
andowner Name: 3 c	enic Rivers			
HEREBY CERTIFY that the vequirements of the Mississi applicable, and state laws	ppi bepartment of Environme	ristructed, and completed in acceptal Quality and the Mississippi	ordance with all appl Department of Health	icable regulations,
Clinton Dunn		9/28/21 Centar	Dunn	
rint Name of Responsible L	icensee and License No.	Date Si	gnature of Licensee	
			Form: OLWF	R-SWR-1B (4/1

For Office Use Only:

County: _

STATE WELL REPORT

Part 2

Pump Installer's Completion Report
Mississippi Department of Environmental Quality
Office of Land and Water Resources

P.O. Box 2309 Jackson, MS 39225-2309 (601)951-5210 (601) 360-0535 (fax)

For O	ffice Use Only:
Well #:	N184
Aquifer: _	

This part of the report must be completed by a licensed water well contractor or a licensed pump installer. A copy of Part 1 of the report must be attached and both parts filed with the Department at the above address within 30 days of well completion. Well Owner Information Latitude: 3/° 9'36.14" Longitude: 90° 50' 15.17 Owner Name: Scenic Rivers Mailing Address: 1068 Dogwood Method of Lat/Long (check one): Conventional Survey USGS quad____, Hand-held GPS____, Survey-grade GPS_ McComb 39648 State liberty ms. 684-9568 Telephone No. (601) (Distance) (Nearest Town) Pump Type (check one Submersible Turbine Air Lift Centrifugal Flowing Well Det Piston Rotary other (clescribe): Date Pump Installed: 10/18/2021 Rated Pump Capacity: 55 Gallons Per Minute Is This Pump (check one): Repaired Replacement Power Type (check one) Electric Diesel Gasoline Natural Gas ☐ Tractor PTO ☐ Windmill ☐ Other (describe): _____ Setting Depth: __ (60 ' Horse Power Rating of Motor: feet Number of Stages: 16 Pump Test Data for Non Flowing Well Date Well Tested: _ 10 /18 / 2071 Duration of Fump Test (minimum 4 hours): _____9 hours Static Water Level (A): 58.7 Feet Below Land Surface Pumping Water Level (B): 173.9 Feet Below Land Surface Drawdown [(B) - (A)]: 69.5 Feet Below Land Surface Test Pumping Rate: ___ 60 Gallons Per Minute Method of measurement (check one): Steel tape [Electric tape Air line Other (describe): SoniC Pump Test Data for Flowing Well Measured shut in head: feet. _____GPM with a drawdown of _____ hours of pumping Meter Installation Meter Manufacturer: _____ Meter Serial Number: ____ Meter Model Number/Name: _____ _____ Type of Meter: Totalizer Register Unit and Multiplier Factor (AF x .001, gal x 1000, etc):_____ Meter installed by: _____ Is This Meter (check one): New Repaired Replacement Important: By submitting the above information you are certifying that this meter was installed to manufacturer standards.


For agricultural wells, a list of approved meters is on the MDEQ website.

I HEREBY CERTIFY that the above statements are true to the b	est of my knowl	edge.
Clinton Dunn MS 0-808		Onto Dunn
Print Name of Pump Installer and License No. (if applicable)	Date	Signature of Pump Installer

Form: OLWR-SWR-2A (4/13)

Google Maps

Google Maps

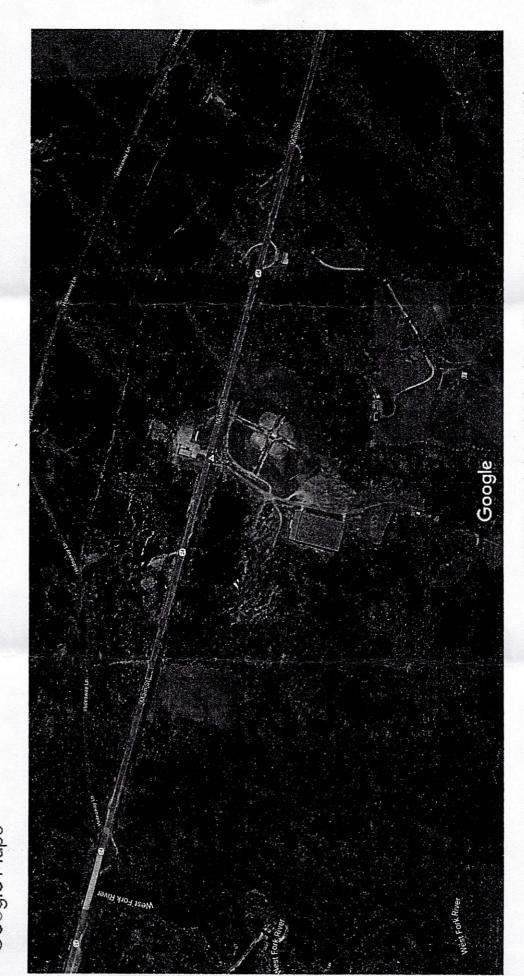

Imagery ©2021 Maxar Technologies, U.S. Geological Survey, USDA Farm Service Agency, Map data ©2021 200 ft 1...

RECEIVED OCT 25 2021 BY OLWR