

AMITE

MISSISSIPPI BOARD OF WATER COMMISSIONERS

N 2000

7-12-65 WATER WELL DRILLERS LOG

Date: 7-12, 1965, Driller: Chester Kerns County, Amite
(Name)

(1) Owner of Land:	Description & Color of Materials	Thick- ness Feet	Depth Feet
J.C. Chapman (Name) Rt-1, Liberty (Address)	Red Clay Red Sand Gravel	15 33 21	15 50 71
(2) Location: 1/4, 1/2, Sec. 36, T. 2R, 4 1 miles west of Liberty (distance) (direction) (Nearest Town)			
(3) Topography: Hilly (Hilly) (Flat) (Level)			
(4) Purpose of Well: Domestic (Domestic Irrigation Municipal, Industrial, Other)			

Information upon completion of well:


- (1) Diameter 4 inches.
- (2) Total Depth 71 feet.
- (3) Water Level 40 feet below top of ground.
- (4) Cased to Bottom Size 4"
- (5) Screen: Size 4", Length 7
- (6) Were any formations sealed against pollution?
yes, no.

Cannot locate RN

If YES depth of formation _____

Why _____

Drillers Remarks: *bad well*

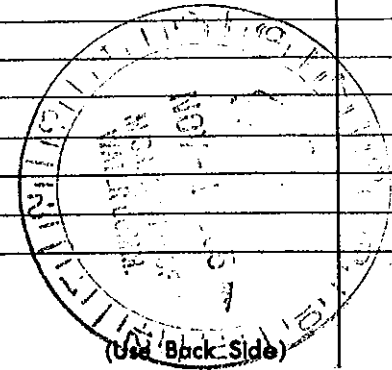

Well No.

Mail this copy to Board of Water Commissioners 429 Miss. St. Jackson, Miss