

WATER WELL DRILLERS LOG

CODED

01
 2-27-62
 Date: 2-27, 1962, Driller: Chester Reeves County Amite
 (Name)


| (1) Owner of Land: | Description & Color of Materials Sand, Clay, Red Clay, Shell, etc. | Thick- ness Feet | Depth Feet |
|--|---|------------------------|---------------|
| (Name) Harold Bates (Address) RFD, Liberty | Clay Red Chalky sand | 20 60 | 20 80 |
| (2) Location: 1/4, 1/4, Sec. 14 T3R5 at Peoria (distance) (direction) (Nearest Town) | Small Red gravel & sand | 9 | 89 |
| (3) Topography: Hilly (Hilly) (Flat) (Level) | | | |
| (4) Purpose of Well: Domestic (Domestic Irrigation Municipal, Industrial, Other) | | | |

Information upon completion of well:

- (1) Diameter 4 inches.
- (2) Total Depth 89 feet.
- (3) Water Level 63 feet below top of ground.
- (4) Cased to Bottom size 4"
- (5) Screen: Size NONE Length _____
- (6) Were any formations sealed against pollution?
 _____ yes, no.

If YES depth of formation _____
 Why _____

Drillers Remarks: old well
 went bad

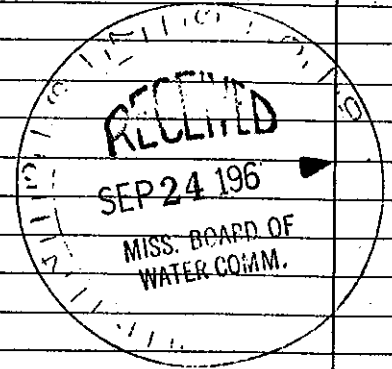

REEVES WELL AND PUMP CO.
 Phone 1250
 McCOMB, MISSISSIPPI

(Use Back Side)

Well No.