

AMITE

MISSISSIPPI BOARD OF WATER COMMISSIONERS

CODED

02
5-22-62

WATER WELL DRILLERS LOG

Date: 5-22, 1962, Driller: Chester Reeves County Amite
(Name)

(1) Owner of Land: Luke White
(Name)
RFD 4, Liberty
(Address)

(2) Location: 9 2.5 1/4, 1/4, Sec. 9 2.5 T. 2 R. 5
(distance) (direction) (Nearest Town)

(3) Topography: Hilly
(Hilly) (Flat) (Level)

(4) Purpose of Well: Domestic
(Domestic Irrigation
Municipal, Industrial, Other)

Description & Color of Materials Sand, Clay, Red Clay, Shell, etc.	Thick- ness Feet	Depth Feet
<u>Clay</u>	<u>20</u>	<u>20</u>
<u>Sandy sand</u>	<u>30</u>	<u>50</u>
<u>Red ground</u>	<u>6</u>	<u>56</u>

Information upon completion of well:

(1) Diameter 4 inches. (plastic)

(2) Total Depth 56 feet.

(3) Water Level _____ feet below top of ground.

(4) Cased to Bottom Size 4"

(5) Screen: Size 4", Length 4'


(6) Were any formations sealed against pollution?
_____ yes, no.

If YES depth of formation _____

Why _____

Drillers Remarks: old well
bad

REEVES WELL AND PUMP CO.

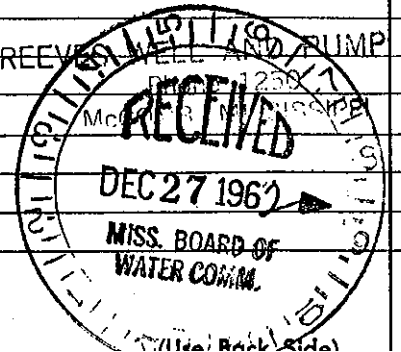

Well No