

MI 11 E
04

MISSISSIPPI BOARD OF WATER COMMISSIONERS

2-13-63

WATER WELL DRILLERS LOG

Driller

Date 2/13, 1963

Driller

E. B. Jone

County

Lewis

(Name)

(1) Owner of Land: Moss, Holden

(Name)

Rt # 4 - Box 19 Liberty

(Address)

(2) Location: SW NE 1/4, Sec. 26 R. 2 S.

10 miles S.E. of Liberty

(distance)

(direction)

(Nearest Town)

(3) Topography: Hilly

(Hilly)

(Flat)

(Level)

(4) Purpose of Well: Domestic

(Domestic Irrigation
Municipal, Industrial, Other)

Description & Color of Materials
Sand, Clay, Red Clay, Shell, etc.

Thick-
ness
Feet

Depth
Feet

Red Sh. Cl

0 90

Sand & Gravel

90 127

Information upon completion of well:

(1) Diameter 4 1/2 inches.

(2) Total Depth 127 feet.

(3) Water Level 80 feet below top of ground.

(4) Cased to 127, Size 2"

(5) Screen: Size .010, Length 5

(6) Were any formations sealed against pollution?


yes, No no.

If YES depth of formation

Why

Drillers Remarks:

Good well

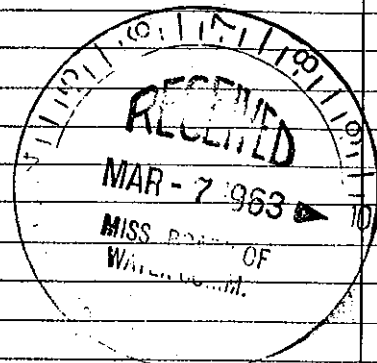

Well