

**CODED**

4471 4896

011  
7-12-63

WATER WELL DRILLERS LOG

Date: 7-12, 1963, Driller: Chester Deane County: Amite  
(Name)

(1) Owner of Land: N. P. Travis, Jr.  
(Name)  
470 2 Liberty  
(Address)


(2) Location: 1/4, 1/4, Sec. 33 T2 R5  
12 miles west of Nopalva  
(distance) (direction) (Nearest Town)

(3) Topography: Hilly  
(Hilly) (Flat) (Level)

(4) Purpose of Well: Domestic  
(Domestic Irrigation  
Municipal, Industrial, Other)

Description & Color of Materials Sand, Clay, Red Clay, Shell, etc.	Thick- ness Feet	D
<u>Surface Clay</u>	<u>10</u>	<u>10</u>
<u>Sand &amp; gravel</u>	<u>62</u>	<u>72</u>

**CODED**

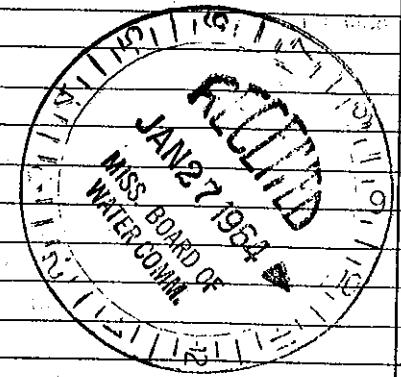

Information upon completion of well:

- (1) Diameter 4 inches.
- (2) Total Depth 72 feet.
- (3) Water Level 50 feet below top of ground.
- (4) Cased to bottom Size 4"
- (5) Screen: Size 4", Length 5'
- (6) Were any formations sealed against pollution?  
\_\_\_\_\_ yes, ✓ no.

If YES depth of formation \_\_\_\_\_

Why \_\_\_\_\_

Drillers Remarks: old well bad.

REEVES WELL & PUMP CO.  
P. O. BOX 71 PHONE 684-1451  
McCOMB, MISS.