County: Amte	
Permit #:	Ι.
Driller: Fitzgeral (d. hell kup.	^
Date drilling completed: 1-28-15	

## STATE WELL REPORT Part 1 Driller's Log

Mississip	pi Department of Environmental Quality
Of	fice of Land and Water Resources
	P.O. Box 2309
	Jackson, MS 39225-2309
	(601)961-5210
	(601)360-0535 (fax)


For Office Use Only: well #: 0109
Aquifer:
E-Log #:

State Law requires that this report be prepared by the license holder responsible for the work and filed with the Department at the above address within 30 days of completion of drilling of the well or borehole.

Well Owner Information (Landowner if borehole is not for a water well)	Well or Borehole Location	
Owner Name: Vammie Stone.	Latitude: 31° /0 /0 /Longitude: 40° 39 37.2	11
Mailing Address: <u>Turner</u> Rd	Method of Lat/Long (check one): Conventional Survey	
	USGS quad, Hand-held GPS, Survey-grade GPS	-
Liberty MS	SE INW 14, Sec   T 2N B 5E	
City / State Zip Code		[
Telephone No. ()	(Distance) (Direction) (Nearest Town)	
Woll / B	orehole Data	J 
Date drilling started: 1-29-15 Date drilling completed:	<u>1-28-15</u> Hole depth: <u>115</u> Hole diameter: <u><math>8^{\prime\prime}</math></u>	
	ng: note depent note diameter:	-
Method of dosing and volume of Chlorine used in drilling ar	nd development:	-
Logs run (circle all applicable): No log run Electric Gamm	na Ray Density Sonic Neutron Other:	-
Name of organization running log(s):		-
Purpose of borehole (circle one): Water Well Geotechnic		-
_		
	describe)	-
Purpose of Well (circle all applicable): Home Industrial	Dublin Contraction	
Other (describe):	Public Supply Irrigation Fish Culture	
f a flowing well, method of flow regulation: Valve		-
tatic Water Level: 56 feet (show and helevel)	Other (describe)	-
tatic Water Level: <u>56</u> feet [above or below] (circle one)	land surface Date measured: $1-d\delta - 15$	-
Aethod of measurement (circle one): Steel tape Electric ta	pe Air line Other (describe):	
/ell depth: Well grouted to a depth of: fee	et Type of grout (circle one): Meat Cement Bentonite Mix	-1
asing length: $10.5$ feet Casing diameter: $4^{\prime}$	inches Type of casing: <u>Puc</u>	
creen length:feet Screen diameter:	inches Type of screen: $\mu$	-
creen slot size: <u><math>\mathcal{O}(\mathcal{O})</math> inches</u> Setting depth: F		-
IDA of completion ( in the state of the stat	Underreamed Open hole Natural Development	CEN
(in the un upplicable). / Uravel packed /	VETTING NATURAL Development	an and showing the
ther (describe):		
		EB I I ZO

## The sketch below only required for water wells

If well telescopes, show depths on sketch, Ground Level

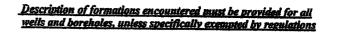

Description of Formations Encountered		To (depth)
	Ground Level	
Clay,	0	20
Sand.	20	100
Chang-	60	80
Sant	- Su	80
(was Jand	80	115
		ļ
	ļ	

If more than one screen, show location of each on sketch

Sketch the property layout and include the following: 1) the well location; 2) a aid in locating the well; 3) any roads, power lines, or other items 4) a north arrow.	2) any permanent structures on the property that may ms that may aid in locating the property and the well; $uel \ge 0$ $\Box = -$ TusnesRd	Hore
	Everef Bels Rd	
Landowner Name: Janamie Turner.	<i>y.</i>	

Form: OLWR-SWR-1A (04/08)

I certify that the well/borehole was drilled, constructed, and completed in accordance with all applicable requirements of the Mississippi Department of Environmental Quality and the Mississippi Department of Health regulations, if applicable, and state

1-28-15

Date

laws. Brad Enterna d-QU,

Print Name of Responsible Licensee and License No.

Signature of Licensee

Amit-l	C STATE WELL REPORT Part 2 Pump Installer's Completion Report Mississippi Department of Environmental Quality Office of Land and Water Resources P.O. Box 10631 Jackson, MS 39289-0631		For Office Use Only Aquifer Well # 01097	
and propieted 1-28-15		961-5210 4-6938 (fax)	Elevation	
This report should be prepared by the			nt within 30 di	ave of the
installation of pump.			li Location	· · · · · · · · · · · · · · · · · · ·
Well Owner Informa		-		deal on 11
Jamie Storl		Latitude 3/010/10/1	_ Longitude <b>%</b>	0 49 342
trange address Turny BQ		Method of Lat/Long (circle or	ne): Conventio	na <sup>r S</sup> atses
		USGS quad. Hand	d-held GPS i si	$\Pi \mathcal{F} = \mathcal{F} + \mathcal{E} : \{ \mathcal{C} \} = \{ \mathcal{F} \}$
Libets Ma		1/4 1/4 Sec	Twr	Rng
City State	Zip Code	Distance Direction	Nearest T	ζρ <b>w</b> τr
Isienhane No. ()		Miles	of	
۰ ۱۹۰۰ - ۲۰۰۰ - ۲۰۰۰ - ۲۰۰۰ - ۲۰۰۰ - ۲۰۰۰ - ۲۰۰۰ - ۲۰۰۰ - ۲۰۰۰ - ۲۰۰۰ - ۲۰۰۰ - ۲۰۰۰ - ۲۰۰۰ - ۲۰۰۰ - ۲۰۰۰ - ۲۰۰۰				
Pump Type Circle one			wer Type Circle one	······································
A to the set	Submersible	Diesel Engine Gasoli	ne Enginç	National Lee
Backed , Piston	Turbine	Electric Motor Hand		Tractor (**
Rotary	Flowing Well	Windmill Other	(specify)	
men specifi		Horse Power Rating of Motor	3/4	
Date Pump Installed: 2-5-15		Setting Depth: 100		* <i>**</i> **
server Prime scapacity	_Gallons Per Minute	Number of Stages:		-
Pump Test Data			easuring Wate	r Level
Date Well Tested 2-5-15			Circle one	
State Water Level (A) _56 Fee	t Below Land Surface	Air Line Electric Me	asuring Line	Stern T gray
Sumping Water Level (B): <u>62</u> Feet		Other (specify):		
mawdown [(Bit (A)]: 6 Fee	t Below Land Surface	For flowing well, measured s	hut in head	1.00 p
est Pumping Rate.	Gallons Per Minute	Well yielded	GPM_with	a drawarow i i
entre rich Pump Test (minimum 4 hours)	):hours	feet after		
				FEB 1 3 201
HEREEN CERTIFY that the above states	$a$ $l_{i}$	f my knowledge	1	
Ernst Name of Pump Installer and License		_ (Amolan)	ke~	BY: OLW

ŧ.,