

Amite
2034

MISSISSIPPI DEPARTMENT OF NATURAL RESOURCES

Bureau of Land and Water Resources

Southport Mall


P.O. Box 10631

Jackson, Mississippi 39209

WATER WELL DRILLERS LOG

11-7 1985 Fitzgerald Sewer Amite
 date well completed firm name county well located

LANDOWNER:	description of formations encountered	from	to
<u>Vermon Canal</u>			
<u>R.B. Liberty, ms.</u> (mailing address)	<u>Red clay</u>	<u>0</u>	<u>20</u>
	<u>Red sand</u>	<u>20</u>	<u>105</u>
	<u>Coarse sand & gravel</u>	<u>105</u>	<u>125</u>
WELL LOCATION:			
sec. <u>33</u> T <u>2</u> N R <u>5</u> E S W			
<u>2</u> miles <u>S</u> of <u>Pravin</u> (distance) (direction) (nearest town)			
WELL PURPOSE: <u>Home</u> (home, irrigation, municipal, industrial)			
WELL COMPLETION DATA:			
(1) diameter (inches) <u>4</u>			
(2) total depth (feet) <u>125</u>			
(3) static water level (feet) <u>95</u> below top of ground.			
(4) casing <u>PVC</u> , <u>115</u> , (material) (depth) <u>4</u> (size) if telescope see back.			
(5) screen <u>10</u> , <u>115</u> (length) (depth to top) <u>4</u> , <u>PVC</u> (size) (material)			
(6) pump <u>1/2</u> , <u>10</u> (HP) (yield gpm) <u>Electric</u> (type power)			
(7) electric log <u>no</u> (yes or no) <u>Seal It</u> (organization running log)			
(8) how well bottom plugged <u>Seal It</u>			
DRILLERS REMARKS:			

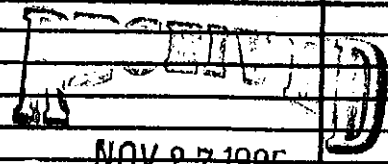

NOV 27 1985

Department of Natural Resources
 Bureau of Land & Water Resources