

70000

Amite
P2
12-66

MISSISSIPPI  
BOARD OF WATER COMMISSIONERS  
416 North State Street  
Jackson, Mississippi 39201

WATER WELL DRILLERS LOG

12-29 1966 date well completed  
 106 Fitzgerald Water Well Service Amite firm name  
 county well located

LANDOWNER: Robert P. Parkerham  
 Liberty Rt Miss  
 (mailing address)

WELL LOCATION:  
 sec 32 T 2 N R 6 E  
 S W  
 6 miles NE of Silksburg  
 (distance) (direction) (nearest town)

WELL PURPOSE: house  
 (home, irrigation, municipal, industrial)

WELL COMPLETION DATA:

(1) diameter (inches) 4

(2) total depth (feet) 88

(3) static water level (feet) 50 below above top of ground.

(4) casing plastic 80  
 (material) (depth)  
 4 (size) If telescope see back.


(5) screen 81 80  
 (length) (depth to top)  
 41 plastic  
 (size) (material)

(6) pump Bucket  
 (HP) (yield gpm)  
 (type power)

(7) electric log No  
 (yes or no)  
 (organization running log)

(8) how well bottom plugged Wood plug

description of formations encountered	from	to
top soil - clay	0	20
hard sand	30	50
fine sand	10	60
chert	8	68
hard gravel	20	88

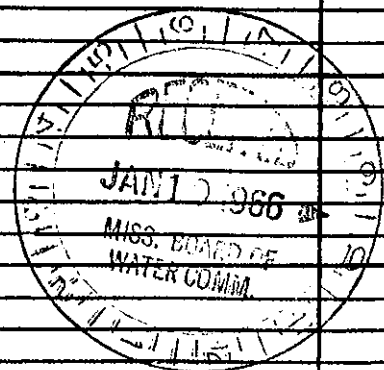

DRILLERS REMARKS: