

Amite  
R3  
6-67

MISSISSIPPI  
BOARD OF WATER COMMISSIONERS  
416 North State Street  
Jackson, Mississippi 39201

CODED

WATER WELL DRILLERS LOG

Amite

June 23 1967 Reeves Well Drilling Co. Amite  
date well completed firm name county well located


LANDOWNER: E. F. Chapman  
Robert A. F. D. 2  
Magnolia, Miss.  
(mailing address)

description of formations encountered	from	to
red clay	0	22
red sand	22	30
red chalk	30	60
red sand gravel	60	90
small gravel and sand	90	100

WELL LOCATION:  
sec. 14 T. 2 N. R. 6 E  
6 miles W of Magnolia  
(distance) (direction) (nearest town)

WELL PURPOSE: Domestic  
(home, irrigation, municipal, industrial)

- WELL COMPLETION DATA:
- diameter (inches) 4"
  - total depth (feet) 100'
  - static water level (feet) 6' below top of ground
  - casing plastic bottom  
(material) (depth)
  - screen 6' 94'  
(length) (depth to top)
  - 14" plastic  
(size) (material)
  - pump 3/4" shaft  
(HP) (yield gpm)
  - elect. (type power)
  - electric log NO.  
(yes or no)
  - (organization running log)
  - how well bottom plugged wooden plugs

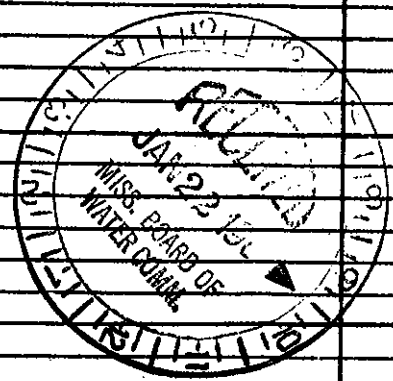

DRILLERS REMARKS: NO previous well