

ANITE

MISSISSIPPI BOARD OF WATER COMMISSIONERS

P5

5044

10-31-63

WATER WELL DRILLERS LOG

CODED

Date: 10-31, 1963, Driller: Chester Renee County Anite

(1) Owner of Land: M. L. Lopez
 (Name)
RTD Magnolia
 (Address)

(2) Location: 1/4, 1/4, Sec. 22 T2R6
 (distance) (direction) (Nearest Town)
8 miles west of Magnolia

(3) Topography: Hilly
 (Hilly) (Flat) (Level)

(4) Purpose of Well: Dambsher
 (Domestic Irrigation
 Municipal, Industrial, Other)

Description & Color of Materials (Sand, Clay, Red Clay, Shell, etc.)	Thick- ness Feet	Dep- th Feet
Red Clay		20-20
Red sandy cherty		
Gravel		20-100
Small gravel & Sand		10-110

Information upon completion of well:

(1) Diameter 4 inches.

(2) Total Depth 110 feet.

(3) Water Level 8.5 feet below top of ground.

(4) Cased to Bottom Size 4"


(5) Screen: Size 4", Length 6'

(6) Were any formations sealed against pollution?
 _____ yes, no.

If YES depth of formation _____

Why _____

Drillers Remarks: good well
bad

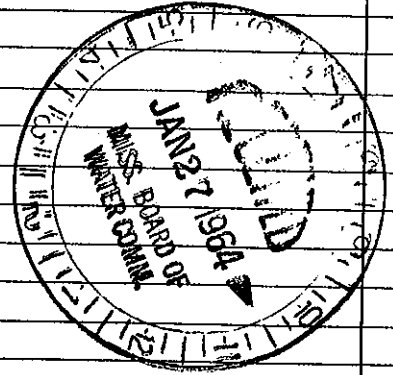

CODED

REEVES WELL & PUMP CO.
 P. O. BOX 71 - PHONE 684-1451
 McCOMB, MISS.

(Use Back Side)

Mail this copy to Board of Water Commissioners 429 Miss. St. Jackson, Miss

Well No.