

Amite
P6
9-66

CODED

MISSISSIPPI BOARD OF WATER COMMISSIONERS

WATER WELL DRILLERS LOG

Amite

Date: 9 22, 1966, Driller: M. Ditzgen County: Amite
(When well drilled) (Name) (Where well is located)

(1) Owner of Land:	Description & Color of Materials Sand, Clay, Red Clay, Shell, etc.	Thick- ness Feet	Depth Feet
<u>Shuman Church</u> (Name) <u>Magaha</u> (Address)	<u>Top soil</u>	<u>5</u>	<u>5</u>
	<u>Clay</u>	<u>35</u>	<u>40</u>
	<u>Red sand</u>	<u>20</u>	<u>64</u>
	<u>gravel</u>	<u>8</u>	<u>72</u>
	<u>Red chalk</u>	<u>10</u>	<u>82</u>
	<u>hard gravel</u>	<u>18</u>	<u>100</u>

2) Location: NE 1/4, NE 1/4, Sec. 24 T2 R6
8 miles W, of Magaha
(distance) (direction) (Nearest town)

3) Topography: hilly
(Hilly) (Flat) (Level)


4) Purpose of Well: Church
(Domestic Irrigation
Municipal, Industrial, Other)

Information upon completion of well:

- 1) Diameter 4 inches.
- 2) Total Depth 100 feet.
- 3) Water Level 60 feet below top of ground.
- 4) Cased to 92, Size 4.
- 5) Screen: Size 4", Length 8'.
- 5) Were any formations sealed against pollution?
 yes, no.

YES depth of formation _____
Why _____
Drillers Remarks: _____
Yield in gpm: 10 gal per min
Size pump: 1/2 HP
Type power: Electric

CODED

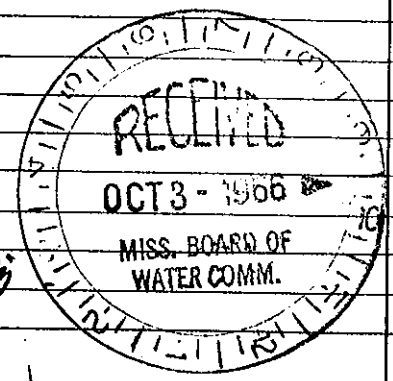

Mail this copy to Board of Water Commissioners 429 Miss. St. Jackson, Miss.