

AMITE MISSISSIPPI BOARD OF WATER COMMISSIONERS

P7

4862 5047

10-15-62 WATER WELL DRILLERS LOG

CODED

Date: 10-15, 1962, Driller: Chester Reeves, County, Amite

(1) Owner of Land	Description & Color of Materials Sand, Clay, Red Clay, Shell, etc.	Thick- ness Feet	Depth Feet
Paul Kaura RFD, Magnolia (Name) (Address)	Red Chalk	20	20
(2) Location: 1/4, 1/2 Sec. 19 T2R6	Red Soupy Sand	30	50
9 miles west of Magnolia (distance) (direction) (Nearest Town)	Small gravel & coarse sand	13	63
(3) Topography: Hilly (Hilly) (Flat) (Level)	CODED		
(4) Purpose of Well: Domestic (Domestic Irrigation Municipal, Industrial, Other)			


Information upon completion of well:

- (1) Diameter 4 inches.
- (2) Total Depth 63 feet.
- (3) Water Level 39 feet below top of ground.
- (4) Cased to Bottom, Size 4"
- (5) Screen: Size 4", Length 4"
- (6) Were any formations sealed against pollution?
yes, no.

If YES depth of formation _____

Why _____

Drillers Remarks: Good well
Berd

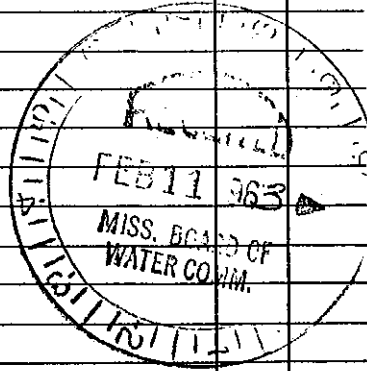

REEVES WELL & PUMP CO.
P. O. BOX 71 - PHONE 684-1451
McCOMBE, MISS.

(Use Back Side)

Well No.

Mail this copy to Board of Water Commissioners 429 Miss. St. Jackson, Miss.