

Amite
P 46
8-26-75

MISSISSIPPI
 BOARD OF WATER COMMISSIONERS
 416 North State Street
 Jackson, Mississippi 39201

CODED

WATER WELL DRILLERS LOG

26 Aug. 1975 J. C. Brantson Amite
 date well completed firm name county well located

LANDOWNER:
L. Mc Chamberlin
Map
 (mailing address)

description of formations encountered	from	to
<u>clay</u>	<u>0</u>	<u>25</u>
<u>red clay</u>	<u>25</u>	<u>45</u>
<u>cherty</u>	<u>45</u>	<u>65</u>
<u>sand</u>	<u>65</u>	<u>94</u>

WELL LOCATION:
 sec 26 T 20 N R 06 E 14G
10 miles west of Map
 (distance) (direction) (nearest town)

WELL PURPOSE:
 (home, irrigation, municipal, industrial)

WELL COMPLETION DATA:

(1) diameter (inches) 4

(2) total depth (feet) 94

(3) static water level (feet) 75 below above top of ground.

(4) casing pl 98
 (material) (depth)
 (size) if telescope see back.

(5) screen 6 98
 (length) (depth to top)
4 pl
 (size) (material)


(6) pump 1/2 5
 (HP) (yield gpm)
elect
 (type power)

(7) electric log _____
 (yes or no)

 (organization running log)

(8) how well bottom plugged wood

DRILLERS REMARKS:

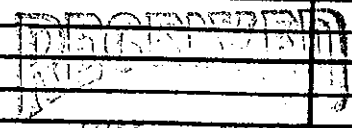

AUG 26 1975