

RECEIVED
 JUN 21 1987
 5:00 PM

Form: OLWR-SWR-1A

Well / Borehole Data

Date drilling started: 7-2-07 Date drilling completed: 7-2-07 Hole depth: 113' Hole diameter: 2"

Location of the source of any surface water used for drilling: _____
 Method of dosing and volume of Chlorine used in drilling and development: _____

Logs run (circle all applicable): No log run Electric Gamma Ray Density Sonic Neutron Other: _____
 Name of organization running logs: _____

Purpose of borehole (check one): Water Well Geotechnical/Geological Investigation Ground Source Heat Pump
Seismic Survey Other (describe) _____

If drilling is not related to water well construction, skip the remainder of this block

Purpose of Well (check one): Home Industrial Public Supply Irrigation Fish Culture Other: _____

If a flowing well, method of flow regulation: Valve Other (describe) _____

Static Water Level: 82' feet above or below (circle one) land surface Date measured: 7-2-07

Method of Measurement (circle one) steel tape electric tape air line other: _____

Well depth: 113' Well grouted to a depth of 10' feet Type of grout (circle one) Neat Cement Bentonite Mix

Casing length: 103' feet Casing diameter: 4" inches Type of casing: PVC

Screen length: 10' feet Screen diameter: 4" inches Type of screen: PVC

Screen slot size: .012 inches Setting depth: From 103' feet to 113' feet

Type of completion (circle all applicable): Gravel packed Underrammed Telescoped Open hole Natural Development

Other (describe): _____

Top of lap pipe or reduction in casing: _____ feet. *If telescoped or more than one screen, describe on next page*

State Law requires that this report be prepared by the license holder responsible for the work and filed with the Department at the above address within 30 days of completion of drilling of the well or borehole.

For Office Use Only:

Acquirer: P-80

Well #: _____

L. S. Elevation: _____

E-log #: _____

State Well Report
 Part I - Driller's Log
 Mississippi Department of Environmental Quality
 Office of Land and Water Resources
 P.O. Box 10631
 Jackson, MS 39289-0631
 (601)961-5210
 (601)354-6938 (fax)

County: Amite

Permit #: _____


Driller: Hyatt Wells

Date drilling completed: 7-2-07

The sketch below only required for water wells.

If well screens, show depths on sketch.

Ground Level \overline{K}

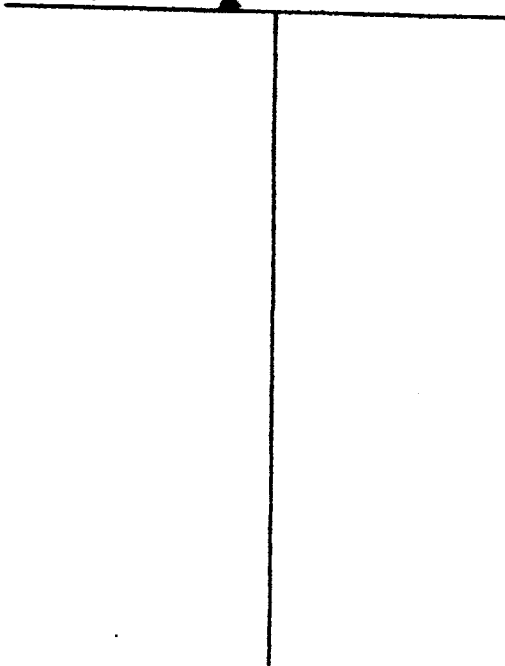


Description of formations encountered must be provided for all wells and boreholes unless specifically exempted by regulation.

Description of Formations Encountered	From (depth)	To (depth)
	Ground Level	
Clay	0	20
Sand	20	60
Gravel	60	80
Sand	80	100
Coarse Sand	100	113

If more than one screen, show location of each on sketch

Sketch the property layout and include the following: 1) the well location; 2) any permanent structures on the property that may aid in locating the well; 3) any roads, power lines, or other items that may aid in locating the property and the well; 4) a north arrow.

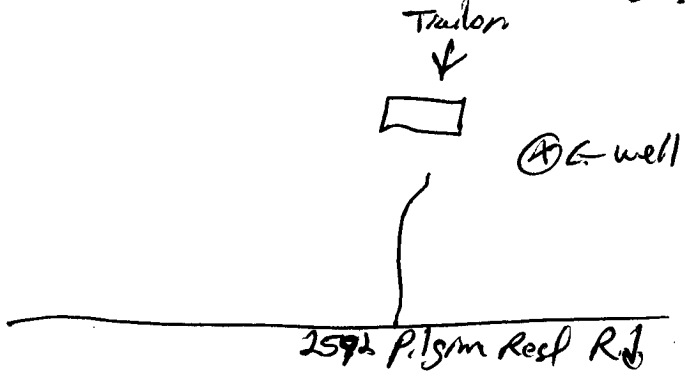

Landowner Name: Blinnard Lirette

I certify that the well/borehole was drilled, constructed, and completed in accordance with all applicable requirements of the Mississippi Department of Environmental Quality and the Mississippi Department of Health regulations, if applicable, and state laws.

Form: OLWR-SWR-1A

Brad Fitzgerald 089 7-2-07 Rud Stark
 Print Name of Responsible Licensee and License No. Date Signature of Licensee

11/15/07
 11:20
 11/15/07

STATE WELL REPORT

Part 2

Pump Installer's Completion Report
Mississippi Department of Environmental Quality
Office of Land and Water Resources

P.O. Box 10631
Jackson, MS 39289-0631

(601)961-5210

(601)354-6938 (fax)

For Office Use Only:

Aquifer: _____

Well #: P-80

Elevation: _____

County: Amite

Permit #: _____

Driller: Etzel & Willis

Date completed: 7-2-07

This part of the report must be completed by a licensed water well contractor or a licensed pump installer. A copy of Part 1 of the report must be attached and both parts filed with the Department at the above address within 30 days of well completion.

Well Owner Information

Owner Name: Linnard Livette

Mailing Address: 2502 Pilsim Rest Rd

City: Meridian MS State: _____ Zip Code: _____

Telephone No. () _____

Well Location

Latitude: 31° 46' 11" Longitude: 90° 30' 22" W

Method of Lat/Long (check one): Conventional Survey _____

USGS quad _____ Hand-held GPS _____ Survey-grade GPS _____

Distance _____ Direction _____ Nearest Town _____

Miles _____ of _____

Pump Type

Circle one

Air Lift Jet Turbine Submersible

Bucket Piston Turbine

Centrifugal Rotary Flowing Well

Other (specify): _____

Date Pump Installed: 7-2-07

Rated Pump Capacity: _____ Gallons Per Minute

Power Type

Circle one

Diesel Engine Gasoline Engine Hand Tractor PTO

Electric Motor

Windmill Other (specify): 1/2

Horse Power Rating of Motor: _____

Setting Depth: 110 feet

Number of Stages: 8

Pump Test Data

Date Well Tested: _____

Static Water Level (A): _____ Feet Below Land Surface

Pumping Water Level (B): _____ Feet Below Land Surface

Drawdown (B) - (A): _____ Feet Below Land Surface

Test Pumping Rate: _____ Gallons Per Minute

Duration of Pump Test (minimum 4 hours): _____ hours

Method of Measuring Water Level

Circle one

Air Line Electric Measuring Line Steel Tape

Other (specify): _____

For flowing well, measured shut in head: _____ feet

Well yielded _____ GPM with a drawdown of _____ feet

_____ feet after _____ hours of pumping

I HEREBY CERTIFY that the above statements are true to the best of my knowledge.

Print Name of Pump Installer and License No. (if applicable): Brad E. Taylor H. 0291

Signature of Pump Installer: Brad E. Taylor