

Amite
Q1
7-66

MISSISSIPPI BOARD OF WATER COMMISSIONERS

CODED

WATER WELL DRILLERS LOG


Date: 7-18, 1966, Driller: Seneca Well Pump County: Amite
(When well drilled) (Name) (Where well is located)

		Description & Color of Materials Sand, Clay, Red Clay, Shell, etc.	Thick- ness Feet	Depth Feet
(1) Owner of Land:	<u>C.C. Callender</u> <small>(Name)</small>	<u>Top clay</u>	<u>10</u>	<u>10</u>
	<u>RFD, Liberty</u> <small>(Address)</small>	<u>Red sand</u>	<u>15</u>	<u>25</u>
(2) Location:	<u>1/4, 1/4 Sec. 17 T. 1 R. 2</u> <small>(distance) (direction) (Nearest Town)</small>	<u>Red gravel sand</u>	<u>15</u>	<u>40</u>
	<u>8 miles east Centerville</u> <small>(distance) (direction) (Nearest Town)</small>	<u>Blue chalk with streaks of fine sand</u>	<u>180</u>	<u>220</u>
(3) Topography:	<u>Hilly</u> <small>(Hilly) (Flat) (Level)</small>	<u>Coarse sand</u>	<u>30</u>	<u>250</u>
(4) Purpose of Well:	<u>Domestic</u> <small>(Domestic Irrigation Municipal, Industrial, Other)</small>			

Information upon completion of well:

- (1) Diameter 2 inches.
- (2) Total Depth 250 feet.
- (3) Water Level 42 feet below top of ground.
- (4) Cased to Battain, Size 2"
- (5) Screen: Size 1 1/4, Length 6'
- (6) Were any formations sealed against pollution?
 yes, no.

If YES depth of formation _____
 Why _____
 Drillers Remarks: NEW
 Yield in gpm: 20
 Size pump: An air lift
 Type power: was installed

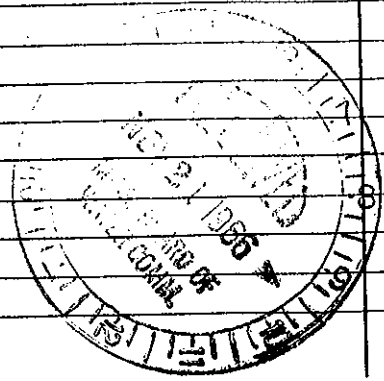

copy to Board of Water Commissioners 429 Miss. St. Jackson, Miss.