

# State Well Report

Part 1

Mississippi Department of Environmental Quality  
Office of Land and Water Resources  
P.O. Box 10631  
Jackson, MS 39289-0631  
(601)961-5210  
(601)354-6938 (fax)

For Office Use Only:

Aquifer: \_\_\_\_\_  
Well #: Q42  
L. S. Elevation: \_\_\_\_\_  
E-log #: \_\_\_\_\_

County: Amite  
Permit #: \_\_\_\_\_  
Driller: Gary Rayborn  
Date drilling completed: 6/30/12

State Law requires that this report be prepared by the driller in detail and filed with the Department within 30 days of completion of drilling of the well.

Well Owner Information	Well Location
Owner Name: <u>ENCANA / Pinnergy by Ltd</u>	Latitude: <u>31° 01' 48"</u> Longitude: <u>90° 58' 42"</u>
Mailing Address: <u>P. O. Box 202</u> <u>Carthage, TX 75633</u> City State Zip Code	Method of Lat/Long (circle one): Conventional Survey, USGS quad, Hand-held GPS, Survey-grade GPS
Telephone No. ( ):	<u>SW</u> ¼ <u>SE</u> ¼ Sec. <u>31</u> Twn <u>1N</u> Rng <u>2E</u> Distance <u>5</u> Miles Direction <u>SE</u> of Nearest Town <u>Centreville</u>

**Well Data**

Purpose of Well (circle one) Home Industrial Public Supply Irrigation Fish Culture Other: Rig Supply

Date well drilling started: 6/29/12 Date well drilling completed: 6/30/12

If flowing, method of flow regulation: Valve \_\_\_\_\_ Other (describe) \_\_\_\_\_

Static Water Level: 110 feet above below (circle one) land surface Date measured: 6/30/12

Method of Measurement (circle one) steel tape electric tape air line other: \_\_\_\_\_

Hole depth: 240 Well depth: 240 Well grouted to a depth of 10 feet

Type of grout (circle one): Cement Bentonite Mix

Casing length: 200 feet Casing diameter: 4 inches Type of casing: PVC

Screen length: 40 feet Screen diameter: 4 inches Type of screen: PVC

Screen slot size: .020 inches Setting depth: From 200 feet to 240 feet

Type of completion (circle all applicable): Gravel packed Underreamed Telescoped Open hole Natural Development

Other (describe): \_\_\_\_\_

Top of lap pipe or reduction in casing: \_\_\_\_\_ feet. If telescoped or more than one screen, describe on back of page

Logs run (circle all applicable): No log run Electric Gamma Ray Density Sonic Neutron Other: \_\_\_\_\_

Name of organization running log(s): \_\_\_\_\_

I certify that the well was drilled, constructed, and completed in accordance with all applicable requirements of the Mississippi Department of Environmental Quality and/or the Mississippi Department of Health regulations and state laws.

RAYBORN DRILLING, INC. 0-60  
Print Name of Water Well Contractor and License No.

[Signature]  
Signature of Water Well Contractor

**RECEIVED**  
JUL 09 2012  
BY: OLWR

Faint, illegible text at the top of the page, possibly a header or introductory paragraph.

Second block of faint, illegible text in the middle of the page.

Third block of faint, illegible text at the bottom of the page.

**JIM, DONALD WILSON**

If well telescopes please sketch below and show depths.

Ground Level

BY: OLVWR

JUL 9 2012

RECEIVED


Description of Formations Encountered

From To

Description of Formations Encountered	From	To
Red, Sandy Clay	0	80
Chalk	80	195
Medium Sand	195	240

If more than one screen, show location of each on sketch

Sketch the property layout and include the following: 1) the well location; 2) any permanent structures on the property that may aid in locating the well; 3) any roads, power lines, or other items that may aid in locating the property and the well; 4) indicate direction.

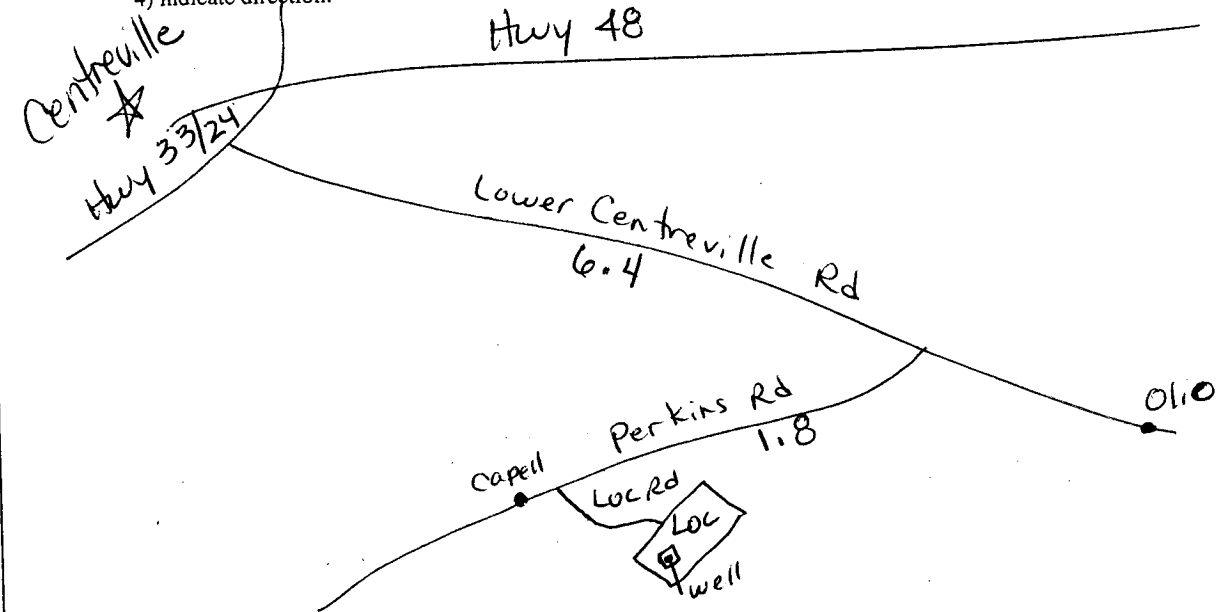

Landowner Name: \_\_\_\_\_

\_\_\_\_\_  
Signature of Water Well Contractor

# STATE WELL REPORT

## Part 2

**Pump Installer's Completion Report**  
 Mississippi Department of Environmental Quality  
 Office of Land and Water Resources  
 P.O. Box 10631  
 Jackson, MS 39289-0631  
 (601)961-5210  
 (601)354-6938 (fax)

**For Office Use Only:**

Aquifer: \_\_\_\_\_  
 Well #: Q42  
 Elevation: \_\_\_\_\_

County: AMITE  
 Permit #: \_\_\_\_\_  
 Driller: GARY RAYBORN  
 Date completed: 6/30/12

This report should be prepared by the pump installer in detail and filed with the Department within 30 days of the installation of pump.

Well Owner Information	Well Location
Owner Name: <u>ENCANA by Pinnergy Ltd.</u> Mailing Address: <u>P.O. Box 202</u> <u>Carthage TX 75633</u> <small>City State Zip Code</small> Telephone No. (____) _____	Latitude: _____ Longitude: _____ Method of Lat/Long (circle one): Conventional Survey, USGS quad, Hand-held GPS, Survey-grade GPS <u>SW</u> ¼ <u>SE</u> ¼ Sec <u>31</u> Twn <u>1N</u> Rng <u>2E</u> Distance Direction Nearest Town <u>5</u> Miles <u>SE</u> of <u>Centreville</u>

Pump Type Circle one	Power Type Circle one
Air Lift Jet <input checked="" type="checkbox"/> Submersible Bucket Piston Turbine Centrifugal Rotary Flowing Well Other (specify): _____ Date Pump Installed: <u>7/2/12</u> Rated Pump Capacity: <u>60</u> Gallons Per Minute	Diesel Engine Gasoline Engine Natural Gas <input checked="" type="checkbox"/> Electric Motor Hand Tractor PTO Windmill Other (specify): _____ Horse Power Rating of Motor: <u>5 HP</u> Setting Depth: <u>168</u> feet Number of Stages: <u>11</u>

Pump Test Data	Method of Measuring Water Level Circle one
Date Well Tested: <u>7/2/12</u> Static Water Level (A): <u>110</u> Feet Below Land Surface Pumping Water Level (B): _____ Feet Below Land Surface Drawdown [(B) - (A)]: _____ Feet Below Land Surface Test Pumping Rate: <u>70</u> Gallons Per Minute Duration of Pump Test (minimum 4 hours): _____ hours	Air Line <input checked="" type="checkbox"/> Electric Measuring Line Steel Tape Other (specify): _____ For flowing well, measured shut in head: _____ feet Well yielded <u>70</u> GPM with a drawdown of _____ feet after _____ hours of pumping

I HEREBY CERTIFY that the above statements are true to the best of my knowledge.

Gary Rayborn 0-60  
 Print Name of Pump Installer and License No. (if applicable)

Signature of Pump Installer

**RECEIVED**

JUL 09 2012

BY: OLWR