	STATE WELL RI	POPT				
County: Amle	Part 1		For Office Use Only:			
Permit #:	Driller's Log		Well #:			
Driller: Fitzgerald Well Jerre	Mississippi Department of Environ Office of Land and Water I	Aquifer:				
Date drilling completed: $9-2-14$,	P.O. Box 2309		E-Log #:			
	Jackson, MS 39225-2 (601)961-5210	309	L-Log #			
	(601)360-0535 (fax	·)				
State Law requires that this report Department at the above address w	be prepared by the license holder i ithin 30 days of completion of dril	responsible for the	e work and filed with the			
well Owner Informati	on i		nole Location			
(Landowner if borehole is not for	a water well) Latitude: <u>31</u> 0	2-9.2" Lon	gitude: <u>90° 58</u> ´ 21.2″			
Owner Name: <u>R.C. Smmong</u>						
Mailing Address:Arking Rd	Method of Lat.	Long (check one)	: Conventional Survey,			
	USGS quad	, Hand-held GP	S, Survey-grade GPS			
<u>Centernik mC</u> City State	SIV 14	<u>11 </u> ¼, Sec	29 TIN R.26			
City State	Zin Code					
Telephone No. ()	(Distance)	(Direction)	(Nearest Town)			
	Well / Borehole Data					
Method of dosing and volume of Chloring Logs run (circle all applicable): No log run Name of organization running log(s): Purpose of borehole (circle one): Water W Seismic If drilling is not related	 Electric Gamma Ray Density Geotechnical/Geological Inv 	Sonic Neutron vestigation Gr	Other:			
Purpose of Well (circle all applicable): No		Irrigation Fis				
Other (describe):						
f a flowing well, method of flow regulation	on: Valve Other (de	scribe)				
itatic Water Level:feet [a	bove or below] land surface (circle one)	Date measured: _	9-2-14			
Nethod of measurement (circle one): Stee	tape Electric tape Air line O	ther (describe):				
/ell depth: 157 Well grouted to a de	pth of: <u>10</u> feet Type of grou	It (circle one): No	at Cement, Bentonite Mix			
asing length: <u>B7</u> feet Casir	g diameter: <u> </u>					
creen length: $\underline{20}^{\prime}$ feet Screen		21				
creen slot size:inches		/				
	Setting depth: From	feet to	157feet			
ype of completion (circle all applicable):	(ravel packed) Underreamed	Open hole	Natural Development			
ther (describe):						
op of lap pipe or reduction in casing:						
If telescoped	or more than one screen, describ	e on next page				

.

÷ -

4.

Q 46

The sketch below only required for water wells

If well telescores, show deaths on sketch. Ground Level


Ν

Description of formations encountered must be provided for all wells and boreholes, unless specifically ecompted by regulations

7

oth) To (Level	0 30	ر ا	40 60	60 20	ere! and	130 130	130 151									
countered	C (with	Sandi	Sand	rect.	(m))	Seylar	/ whe ling									

If more than one screen, show location of each on sketch

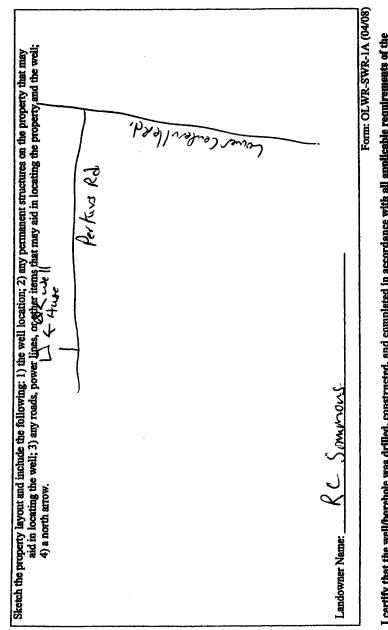

Mississippi Department of Environmental Quality and the Mississippi Department of Health regulations, if applicable, and state I certify that the well/borehole was drilled, constructed, and completed in accordance with all applicable requirements of the

4-8-14 Date 620 RUAD THEANING

Print Name of Responsible Licensee and License No.

Signature of Licensee R

STATE W	VELL REPORT	
County: Amle	Part 2	For Office Use Only:
Permit #- Pump Install		
Mississippi Depart	ment of Environmental Quality and and Water Resources	Well #:A.b
Data completed: (-2-14)	P.O. Box 2309	Aquifer:
Jacks	son, MS 39225-2309 (601)961-5210	Aquiter:
	1) 360-0535 (fax)	
This part of the report must be completed by a licensed wate of the report must be attached and both parts filed with the .	er well contractor or a licensed pun Department at the above address w	np installer. A copy of Part 1 vithin 30 days of well completion.
Well Owner Information		ocation
Owner Name: <u><u><u><u>A</u></u><u><u>C</u><u>Simmont</u></u> Mailing Address: <u><u>Pertms</u><u>R</u><u>A</u></u></u></u>	Latitude: 31° 2 '9.2" Lon	gitude: <u>90°58 21.2"</u>
Mailing Address: Perkins Rd	Method of Lat/Long (check one	: Conventional Survey,
		PS, Survey-grade GPS
Co Par Ila par		<u>29</u> T <u>IN</u> R <u>2E</u>
<u>Centerulle mS</u> City State Zip Code		
Telephone No. ()	(Distance) (Direction)	(Nearest Town)
	ype (circle one)	
Submersible) Turbine Air Lift Centrifugal Flowing Well	•••	scribe):
Date Pump Installed: <u>9-2-14</u>	-	
		Oattons i el mindee
Is This Pump (circle one): (New Repaired Replaceme	ent ype (circle one)	
Electric) Diesel Gasoline Natural Gas Tractor PTO Wi		
Horse Power Rating of Motor: Setting Dep		
Pump Test Data	a for Non Flowing Well	
Date Well Tested:	Duration of Pump Test (minim	um 4 hours): hours
Static Water Level (A): Feet Below Land Surfac	e Pumping Water Level (B):	Feet Below Land Surface
Drawdown [(B) - (A)]:Feet Below Land Su	rface Test Pumping Rate:	Gallons Per Minute
Method of measurement (circle one): Steel tape Electric	tape Air line Other (describe):_	
	ata for Flowing Well	
Measured shut in head:feet.		
Well yieldedGPM with a drawdown of	feet after	hours of pumping
	r installation	
Meter Manufacturer:		
Meter Model Number/Name:	Type of Meter:	
Totalizer Register Unit and Multiplier Factor (AF x .001, ga	al x 1000, etc):	
Installation Date: Meter installed by:		
Is This Meter (circle one): New Repaired Replacem	nent	
Important: By submitting the above information you are of For agricultural wells, a list of a	certifying that this meter was instai pproved meters is on the MDEQ w	lled to manufacturer standards. ebsite.
I HEREBY CERTIFY that the above statements are true to t	he best of my knowledge.	·····
		$f \parallel_{\Lambda}$
Print Name of Pump Installer and License No. (If applicable	19-2-14 Rel	
Print Name of Pump Installer and License No. (If applicable	e) Date Signat	ture of Pump Installer

. . . .

Form: (olwr-	SWR-	1B (4
---------	-------	------	------	---

/13)