

AMITE
R1
4-7-66

MISSISSIPPI BOARD OF WATER COMMISSIONERS

WATER WELL DRILLERS LOG

CODED

Date: 4-7, 1966, Driller: Chester Reeves County Smith
(When well drilled) (Name) (Where well is located)

(1) Owner of Land: Jewell Lambert
(Name)
At. 2, Liberty
(Address)

(2) Location: 1/4, 1/4, Sec 36 T. 1 R. 3
8 miles south of Liberty
(distance) (direction) (Nearest Town)

(3) Topography: Flat
(Hilly) (Flat) (Level)

(4) Purpose of Well: Domestic
(Domestic Irrigation
Municipal, Industrial, Other)

Description & Color of Materials Sand, Clay, Red Clay, Shell, etc.	Thick- ness Feet	Depth Feet
<u>caliche</u>	<u>10</u>	<u>10</u>
<u>mixed sand</u>	<u>68</u>	<u>78</u>
<u>& gravel</u>		

Information upon completion of well:

(1) Diameter 4 inches.

(2) Total Depth 78 feet.

(3) Water Level 28 feet below top of ground.

(4) Cased to Bottom Size 4"

(5) Screen: Size 4", Length 6'

(6) Were any formations sealed against pollution?

no

If YES depth of formation


Why

Drillers Remarks: well had

Yield in gpm: limited 15

Size pump: Sub

Type power: Electric

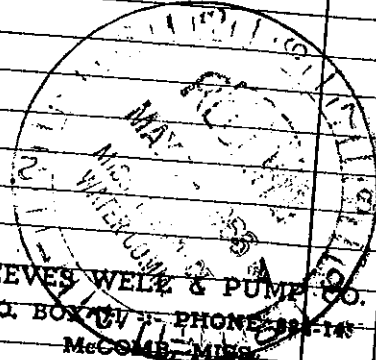

Mail this copy to Board of Water Commissioners 429 Miss. St. Jackson, Miss.