

AMITE
R20
2-14-74

MISSISSIPPI
BOARD OF WATER COMMISSIONERS
416 North State Street
Jackson, Mississippi 39201

CODED

WATER WELL DRILLERS LOG

Feb 14 1974 date well completed
Chestnutrees firm name
Amite county well located

LANDOWNER: Richard Callender
P.O. 5, Liberty
(mailing address)

WELL LOCATION:
sec. 24 T. 1 N. R. 3 E
9 miles SW Liberty
(distance) (direction) (nearest town)

WELL PURPOSE: Home
(home, irrigation, municipal, industrial)


- WELL COMPLETION DATA:
- (1) diameter (inches) 4"
 - (2) total depth (feet) 105
 - (3) static water level (feet) 75 below top of ground
 - (4) casing: Plast ballast (material), (depth) (size) If telescope see back.
 - (5) screen: 6' (length), 99' (depth to top), 4" (size), Plast (material)
 - (6) pump: 1/2 sub (HP), 174 (yield gpm), elect (type power)
 - (7) electric log: No (yes or no)

(organization running log)

(8) how well bottom plugged: woodchips
DRILLERS REMARKS: New house

description of formations encountered	from to	
	feet	feet
Red clay	0	17
Red chalky sand	17	78
Mixed sand & gravel	78	105

CODED

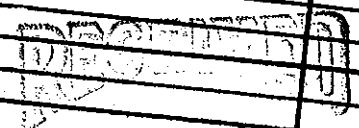

MAY 24 1974