

AMITE  
R37

MISSISSIPPI BOARD OF WATER COMMISSIONERS

2-24-68

WATER WELL DRILLERS LOG

**CODED**

Date: Feb 24, 1968, Driller: J. T. Covington County Amite  
(Name)

(1) Owner of Land: Jimmy Clemond  
(Name)

Liberty Miss  
(Address)

(2) Location: SE 1/4, NW 1/4, Sec. 3 T. 1 R. 3  
(direction)

11 miles S.W. of Liberty  
(distance) (direction) (Nearest Town)

(3) Topography: Hilly  
(Hilly) (Flat) (Level)

(4) Purpose of Well: Home  
(Domestic Irrigation  
Municipal, Industrial, Other)

Description & Color of Materials  
Sand, Clay, Red Clay, Shell, etc.

Thick-  
ness  
Feet

Depth  
Feet

Clay  
Sand & Rocks  
0 30  
30 105

**CODED**

Information upon completion of well:

(1) Diameter 4" inches.

(2) Total Depth 105' feet.

(3) Water Level 80' feet below top of ground.

(4) Cased to 105', Size 4"

(5) Screen: Size 4", Length 6'


(6) Were any formations sealed against pollution?

yes,  no.

If YES depth of formation

Why

Drillers Remarks:

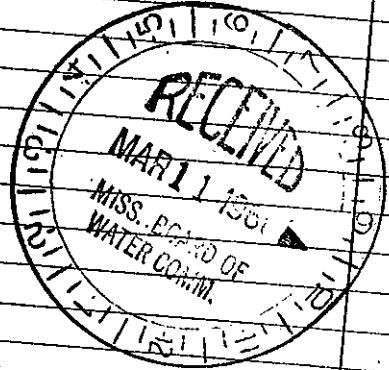

Well No.

Mail this copy to Board of Water Commissioners 429 Miss. St. Jackson, Miss (Use Back Side)