

AMITE
R46
11-27-74

MISSISSIPPI
BOARD OF WATER COMMISSIONERS
416 North State Street
Jackson, Mississippi 39201

CODED

WATER WELL DRILLERS LOG

27 Nov 1974 AT-Greystad Amite
date well completed firm name county well located

LANDOWNER:
Prentiss Shaw
Likely
(mailing address)

description of formations encountered	from	to
<u>Clay</u>	<u>0</u>	<u>25</u>
<u>Gale</u>	<u>25</u>	<u>45</u>
<u>Chalk</u>	<u>45</u>	<u>65</u>
<u>Sand Rock</u>	<u>65</u>	<u>94</u>

WELL LOCATION:
sec. 3 T. 1 N. R. 3 E
6 miles SW of Likely
(distance) (direction) (nearest town)


WELL PURPOSE:
(home, irrigation, municipal, industrial)

- WELL COMPLETION DATA:
- (1) diameter (inches) 4
 - (2) total depth (feet) 94
 - (3) static water level (feet) 25 below
top of ground.
 - (4) casing Pl, 88
(material) (depth)

(size) If telescope see back.
 - (5) screen 6, 88
(length) (depth to top)
4, Pl
(size) (material)
 - (6) pump 1/2, 8
(HP) (yield gpm)
shut
(type power)
 - (7) electric log _____
(yes or no)

(organization running log)
 - (8) how well bottom plugged good

CODED

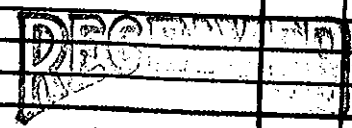

JAN 28 1975

MISS. BD. OF WATER COMMISSIONERS

DRILLERS REMARKS: