

AMITE
R 47
12-4-74

MISSISSIPPI
 BOARD OF WATER COMMISSIONERS
 416 North State Street
 Jackson, Mississippi 39201 **CODED**

WATER WELL DRILLERS LOG

12 Dec
 date well completed

1974 JT Carneghan
 firm name

Amite
 county well located

LANDOWNER:

John Davis
Liberty
 (mailing address)

description of formations encountered

from

Clay	0	20
Clay Sand	20	45
Sand	45	96

WELL LOCATION:

sec. 3 T. 1 N. R. 3 E.
0 miles SW of Liberty
 (distance) (direction) (nearest town)


WELL PURPOSE:

(home, irrigation, municipal, industrial)

WELL COMPLETION DATA:

- (1) diameter (inches) 4
- (2) total depth (feet) 94
- (3) static water level (feet) 60 below top of ground
- (4) casing PI 88
 (material) (depth)
 (size) if telescope see back.
- (5) screen 6 88
 (length) (depth to top)
1 1/2
 (size) PI
 (material)
- (6) pump 1/2 8
 (HP) (yield gpm)
Electric
 (type power)
- (7) electric log _____
 (yes or no)

CODED

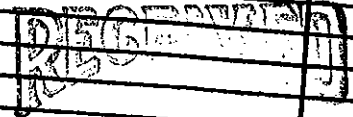

JAN 28 1975

MISS. BD. OF WATER COMM

(organization running log)

(8) how well bottom plugged wood

DRILLERS REMARKS: