

Amite  
 R 2001  
 9-11-75

MISSISSIPPI  
 BOARD OF WATER COMMISSIONERS  
 416 North State Street  
 Jackson, Mississippi 39201

WATER WELL DRILLERS LOG

Sept 11  
 date well completed 1975

Reuss Well Co  
 firm name

Amite  
 county well located

LANDOWNER:  
 Jordan Cannon  
 Rt. Liberty  
 (mailing address)

description of formations encountered	depth	
	from	to
Red Clay	0	20
Chalky sand & gravel	20	90
Ground sand	80	92
Argillaceous sand	92	100

WELL LOCATION:  
 sec. 37 T 1 N R 3 E  
 3 miles South of Street  
 (distance) (direction) (nearest town)


WELL PURPOSE: Drinking  
 (home, irrigation, municipal, industrial)

- WELL COMPLETION DATA:
- (1) diameter (inches) 4"
  - (2) total depth (feet) 100
  - (3) static water level (feet) 115 below top of ground.
  - (4) casing Plastic (material), bottom (depth)  
 (size) If telescope see back.
  - (5) screen 6" (length), 94 (depth to top)  
4" (size), Plastic (material)
  - (6) pump 2.5 (HP), 10 (yield gpm)  
elect (type power)
  - (7) electric log no (yes or no)

(organization running log)

(8) how well bottom plugged  
wooden plug

DRILLERS REMARKS:  
well location

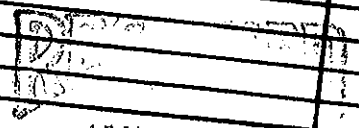

JAN 2 1976

MISS. BD. OF WATER COMM