

Amite
R 2003
2/23/76

MISSISSIPPI
 BOARD OF WATER COMMISSIONERS
 416 North State Street
 Jackson, Mississippi 39201

WATER WELL DRILLERS LOG

Feb 23 1976 Recess Well Service Amite
 date well completed firm name county well located

LANDOWNER:
Prosie Turner
Box 2 Liberty
 (mailing address)

WELL LOCATION:
 sec. 37 T-1 N R-3 E
9 1/2 miles S-SW of Liberty
 (distance) (direction) (nearest town)


WELL PURPOSE: home
 (home, irrigation, municipal, industrial)

WELL COMPLETION DATA:

- (1) diameter (inches) 4"
- (2) total depth (feet) 90
- (3) static water level (feet) 41 below top of ground.
- (4) casing Plastic bottom
 (material) (depth)
- (size) if telescope see back.
- (5) screen 6" 84
 (length) (depth to top)
- (size) 1" plastic
 (material)
- (6) pump Sub 10
 (HP) (yield gpm)
- (type power) elect
- (7) electric log no
 (yes or no)
- (organization running log)
- (8) how well bottom plugged wooden plug

description of formations encountered	from to	
	feet	feet
<u>Clay</u>	<u>0</u>	<u>10</u>
<u>fine sand</u>	<u>10</u>	<u>50</u>
<u>sandy</u>	<u>50</u>	<u>60</u>
<u>Coarse sand</u>	<u>60</u>	<u>70</u>
	<u>70</u>	<u>90</u>

DRILLERS REMARKS:
Good Drilling

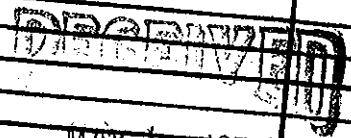

MAY 10 1976

MISSISSIPPI BOARD OF WATER COMMISSIONERS