


AMATE
R 2011
6-21-80
June 21 1980
 date well completed

MISSISSIPPI
 BOARD OF WATER COMMISSIONER
 416 North State Street
 Jackson, Mississippi 39201

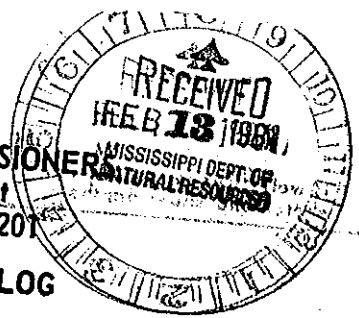

WATER WELL DRILLERS LOG

firm name Amite
 county well located

LANDOWNER:
Bobby Jones
Rt Liberty
 (mailing address)

WELL LOCATION:
 sec. 17 T L N R 3 E
7 miles W. SW of Liberty
 (distance) (direction) (nearest town)

WELL PURPOSE:
Trailer
 (home, irrigation, municipal, industrial)

WELL COMPLETION DATA:

- (1) diameter (inches) 4"
- (2) total depth (feet) 52'
- (3) static water level (feet) 19 below top of ground.
- (4) casing Plastic, bottom
 (material) (depth)
- (5) screen 5' 47'
 (length) (depth to top)
4" Plastic
 (size) (material)
- (6) pump 3/4 12
 (HP) (yield gpm)
electric
 (type power)
- (7) electric log no
 (yes or no)
- (organization running log)

(8) how well bottom plugged
Bottom not plugged

DRILLERS REMARKS:
✓

description of formations encountered	from to	
<u>Clay & gravel</u>	<u>0</u>	<u>12</u>
<u>Chalk & sand</u>	<u>12</u>	<u>36</u>
<u>sand & gravel</u>	<u>36</u>	<u>52</u>

DEPT. OF NATURAL RESOURCES
 BUREAU OF LAND & WATER RESOURCES

