

Lewis

1092

STATE WELL REPORT

Part 1

Driller's Log

Mississippi Department of Environmental Quality
Office of Land and Water Resources
P.O. Box 2309
Jackson, MS 39225-2309
(601)961-5210
(601)360-0535 (fax)

For Office Use Only:

Well #: S 59
Aquifer: _____
E-Log #: _____

County: Amite
Permit #: _____
Driller: John W Thompson
Date drilling completed: 3-19-14

Received

State Law requires that this report be prepared by the license holder responsible for the work and filed with the Department at the above address within 30 days of completion of drilling of the well or borehole. MAR 28 2014

BY OLWR

Well Owner Information (Landowner if borehole is not for a water well)	Well or Borehole Location
Owner Name: <u>Encana</u>	Latitude: <u>31° 4' 7"</u> Longitude: <u>90° 50' 35"</u>
Mailing Address: <u>RT2 Box 2462 hwy 786</u> <u>Coushatta LA 71019</u>	Method of Lat/Long (check one): Conventional Survey _____, USGS quad _____, Hand-held GPS <input checked="" type="checkbox"/> , Survey-grade GPS _____
City _____ State _____ Zip Code _____	<u>NW 1/4 NW 1/4</u> Sec <u>7</u> T <u>1N</u> R <u>4E</u>
Telephone No. (____) _____	<u>6</u> Miles <u>S</u> of <u>Liberty</u> (Distance) (Direction) (Nearest Town)

Well / Borehole Data

Date drilling started: 3-17-14 Date drilling completed: 3-19-14 Hole depth: 423 Hole diameter: 7

Location of the source of any surface water used for drilling: Fire Hydrant

Method of dosing and volume of Chlorine used in drilling and development: _____

Logs run (circle all applicable): No log run Electric Gamma Ray Density Sonic Neutron Other: _____

Name of organization running log(s): _____

Purpose of borehole (circle one): Water Well Geotechnical/Geological Investigation Ground Source Heat Pump
Seismic Survey Other (describe) _____

If drilling is not related to water well construction, skip the remainder of this block

Purpose of Well (circle all applicable): Home Industrial Public Supply Irrigation Fish Culture
Other (describe): Fig supply

If a flowing well, method of flow regulation: Valve _____ Other (describe) _____

Static Water Level: 60 feet [above or below land surface] (circle one) Date measured: 3-19-14

Method of measurement (circle one): Steel tape Electric tape Air line Other (describe): _____

Well depth: 420 Well grouted to a depth of: 50 feet Type of grout (circle one): Neat Cement Bentonite Mix

Casing length: 360 feet Casing diameter: 4 inches Type of casing: PVC

Screen length: 60 feet Screen diameter: 4 inches Type of screen: PVC slotted

Screen slot size: .010 inches Setting depth: From 360 feet to 420 feet

Type of completion (circle all applicable): Gravel packed Underreamed Open hole Natural Development

Other (describe): _____

Top of lap pipe or reduction in casing: _____ feet

If telescoped or more than one screen, describe on next page

STATE WELL REPORT

Part 2

Pump Installer's Completion Report
 Mississippi Department of Environmental Quality
 Office of Land and Water Resources
 P.O. Box 2309
 Jackson, MS 39225-2309
 (601)961-5210
 (601) 360-0535 (fax)

County: Amite
 Permit #: _____
 Driller: John W Thompson
 Date completed: 3-19-14
Copy information from block on Part 1

For Office Use Only:

Well #: 559
 Aquifer: _____

This part of the report must be completed by a licensed water well contractor or a licensed pump installer. A copy of Part 1 of the report must be attached and both parts filed with the Department at the above address within 30 days of well completion.

Well Owner Information	Well Location
Owner Name: <u>Encana</u>	Latitude: <u>31°4'7"</u> Longitude: <u>90°50'35"</u>
Mailing Address: <u>At 2. Box 2462 Hwy 786</u> <u>Coushatta LA 71019</u>	Method of Lat/Long (check one): Conventional Survey _____, USGS quad _____, Hand-held GPS _____, Survey-grade GPS _____
City _____ State _____ Zip Code _____	<u>NW</u> ¼ <u>NW</u> ¼, Sec <u>7</u> T <u>1N</u> R <u>4E</u>
Telephone No. (____) _____	<u>6</u> Miles <u>S</u> of <u>Liberty</u> (Distance) (Direction) (Nearest Town)

Pump Type (circle one)

Submersible Turbine Air Lift Centrifugal Flowing Well Jet Piston Rotary Other (describe): _____

Date Pump Installed: 3-14 Rated Pump Capacity: 85 Gallons Per Minute

Is This Pump (circle one): New Repaired Replacement

Power Type (circle one)

Electric Diesel Gasoline Natural Gas Tractor PTO Windmill Other (describe): _____

Horse Power Rating of Motor: 5 Setting Depth: 100 feet Number of Stages: _____

Pump Test Data for Non Flowing Well

Date Well Tested: 3-19-14 Duration of Pump Test (minimum 4 hours): 4 hours

Static Water Level (A): 60 Feet Below Land Surface Pumping Water Level (B): 69 Feet Below Land Surface

Drawdown [(B) - (A)]: 9 Feet Below Land Surface Test Pumping Rate: 50 Gallons Per Minute

Method of measurement (circle one): Steel tape Electric tape Air line Other (describe): _____

Pump Test Data for Flowing Well

Measured shut in head: _____ feet.

Well yielded _____ GPM with a drawdown of _____ feet after _____ hours of pumping

Meter Installation

Meter Manufacturer: _____ Meter Serial Number: _____

Meter Model Number/Name: _____ Type of Meter: _____

Totalizer Register Unit and Multiplier Factor (AF x .001, gal x 1000, etc): _____

Installation Date: _____ Meter installed by: _____

Is This Meter (circle one): New Repaired Replacement


Important: By submitting the above information you are certifying that this meter was installed to manufacturer standards. For agricultural wells, a list of approved meters is on the MDEQ website.

I HEREBY CERTIFY that the above statements are true to the best of my knowledge.

John W Thompson 0-679 3-20-14 John W Thompson
 Print Name of Pump Installer and License No. (if applicable) Date Signature of Pump Installer

Received
 MAR 28 2014
 BY OLWR

Received
MAR 28 2014
BY OLWR

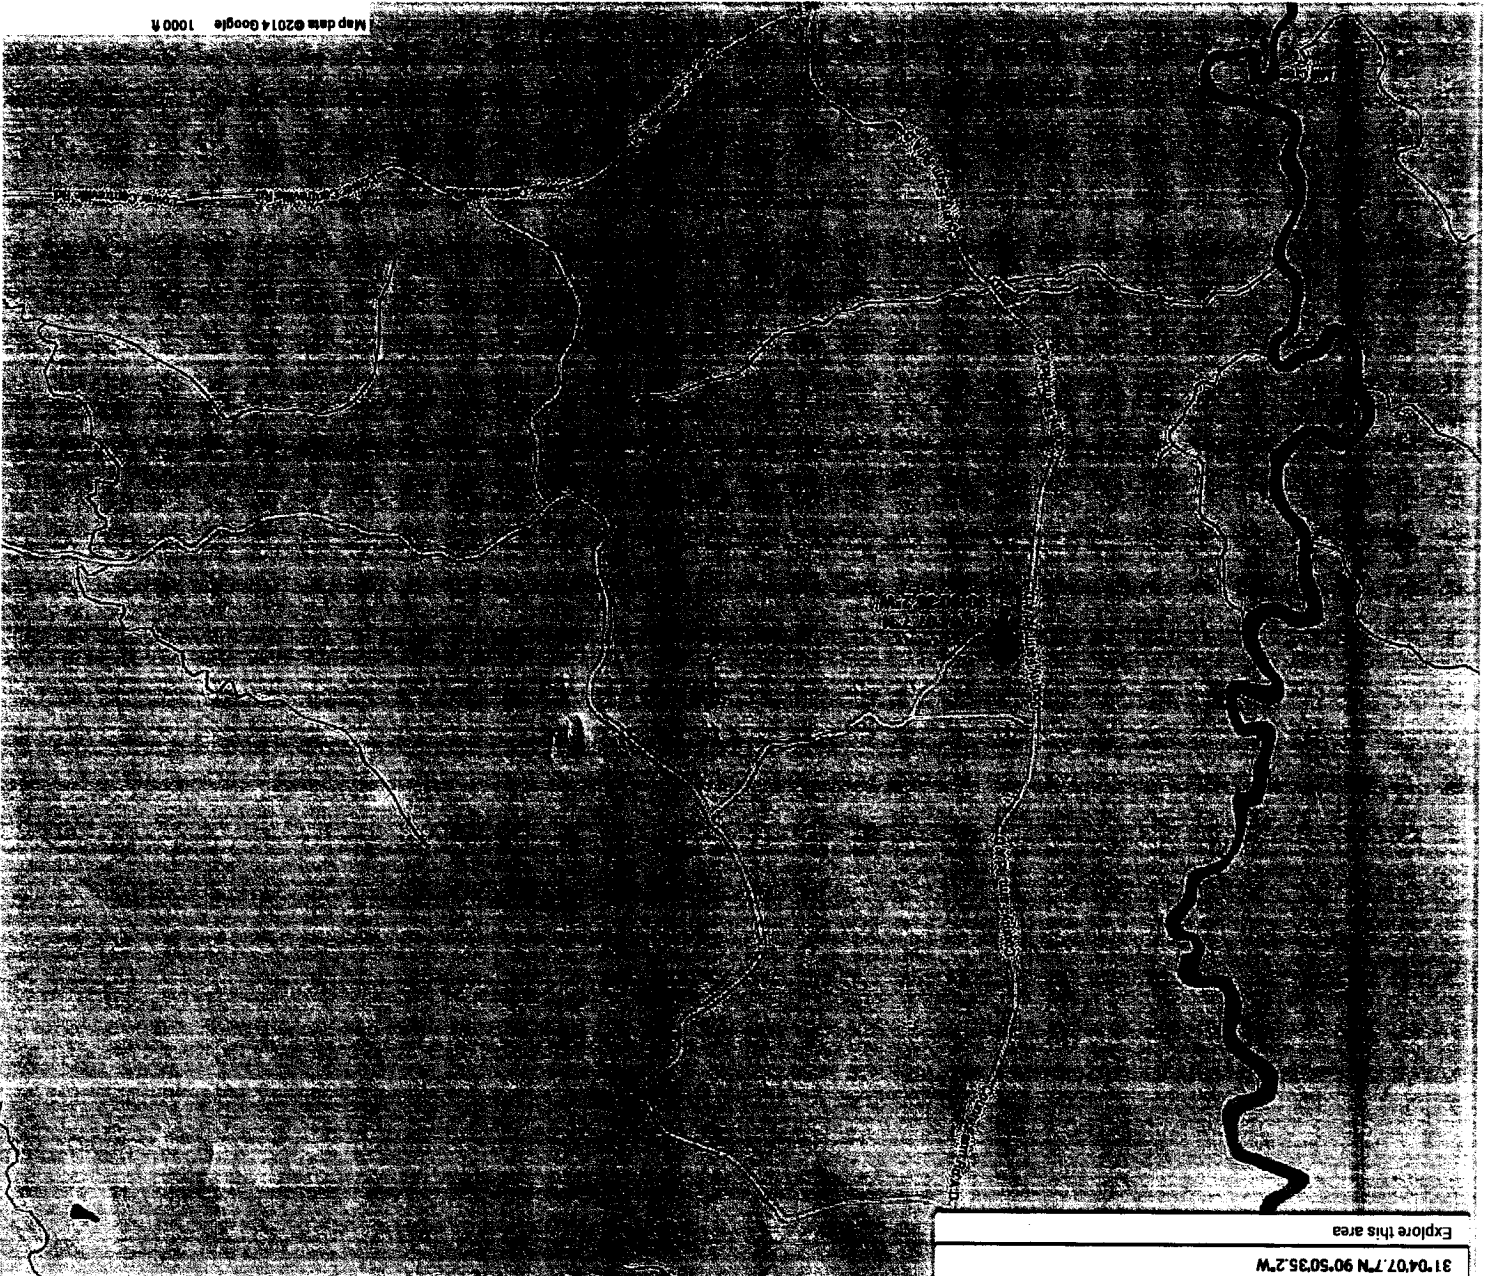

Map data ©2014 Google 1000 ft

Explore this area

31°04'07.7"N 90°50'35.2"W

31°04'07.7"N 90°50'35.2"W - Google Maps

3/20/2014