

AMETE
S 2009
7/26/80
July 26 1980
date well completed

MISSISSIPPI
BOARD OF WATER COMMISSIONERS
416 North State Street
Jackson, Mississippi 39201

WATER WELL DRILLERS LOG

Reems Well Service Amite
firm name county well located

LANDOWNER:

Melvin Blairlock
Liberty
(mailing address)

description of formations encountered

from to

Clay & gravel	0	30
Red sand	30	52
Red Chalk	52	75
Red sand	75	107
sand & gravel	107	119


WELL LOCATION:

sec. 15 T. 1 N R. 4 E
8 miles South of Liberty
(distance) (direction) (nearest town)

WELL PURPOSE: house
(home, irrigation, municipal, industrial)

WELL COMPLETION DATA:

- diameter (inches) 4"
- total depth (feet) 117
- static water level (feet) 80 below top of ground.
- casing plastic bottom
(material) (depth)
- screen 5' 112'
(length) (depth to top)
4" plastic
(size) (material)
- pump 1/2 HP 10
(type power) (yield gpm)
- electric log no
(yes or no)
- how well bottom plugged back wash valve

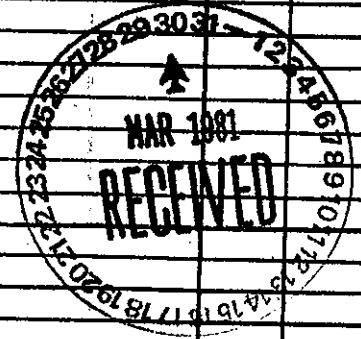

DRILLERS REMARKS: