

AMITE

MISSISSIPPI BOARD OF WATER COMMISSIONERS CODED

T1

10-25-61

WATER WELL DRILLERS LOG

~~F-500~~

Date: 10-25, 1961, Driller: Chester Reeves

County: Amite
(Name)

(1) Owner of Land:	Description & Color of Materials Sand, Clay, Red Clay, Shell, etc.	Thick- ness Feet
Floyd Williams (Name) RD 2, Liberty (Address)	Red & wh. f.e. Clay	30
(2) Location: 1/4, 1/4, Sec. 8 T. 1 R. 5	yellow sand	35
2 miles N.W. Gillsburg (distance) (direction) (Nearest Town)	gravel mixed with white chalk	10
(3) Topography: Hilly (Hilly) (Flat) (Level)	coarse white sand & small gravel	15
(4) Purpose of Well: Domestic (Domestic Irrigation Municipal, Industrial, Other)		90


Information upon completion of well:

- (1) Diameter 4 inches.
- (2) Total Depth 90 feet.
- (3) Water Level 56 feet below top of ground.
- (4) Cased to Bottom, Size 4"
- (5) Screen: Size none, Length _____
- (6) Were any formations sealed against pollution?
_____ yes, no.

If YES depth of formation _____

Why _____

Drillers Remarks: Old well
went bad.

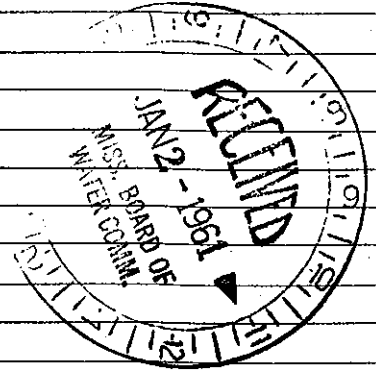

(Use Back Side)

Mail this copy to Board of Water Commissioners 429 Miss. St. Jackson,