

AMITE
T 4
3-20-62

WATER WELL DRILLERS LOG

CODE:

Date: 3-20, 1962, Driller: Chester Reeves County Amite
 (Name)

(1) Owner of Land:	Description & Color of Materials Sand, Clay, Red Clay, Shell, etc.	Thick- ness Feet	Depth Feet
<u>Oliver Brumfield</u> (Name) <u>RFD Osyka</u> (Address)	<u>Red clay</u>	<u>25</u>	<u>25</u>
(2) Location: <u>1/4</u> , <u>1/4</u> , Sec. <u>26</u> T. <u>1</u> R. <u>5</u>	<u>Red sand</u>	<u>53</u>	<u>78</u>
<u>2</u> miles <u>west</u> of <u>Gilking</u>	<u>Sand gravel</u>	<u>8</u>	<u>83</u>
(3) Topography: <u>Hilly</u>	<u>Chalky sand</u>	<u>12</u>	<u>95</u>
(4) Purpose of Well: <u>Domestic</u>	<u>Sand & gravel</u>	<u>10</u>	<u>105</u>
(Domestic Irrigation Municipal, Industrial, Other)	<u>Sandy yellow sand</u>	<u>25</u>	<u>130</u>
	<u>clean sand and</u>		
	<u>pea gravel</u>	<u>5</u>	<u>135</u>


Information upon completion of well:

- (1) Diameter 4 inches Plastic
- (2) Total Depth 135 feet.
- (3) Water Level 75 feet below top of ground.
- (4) Cased to bottom, Size 4"
- (5) Screen: Size 4", Length 4ft.
- (6) Were any formations sealed against pollution?
 yes, no.

If YES depth of formation _____

Why _____

Drillers Remarks: old well
sanded

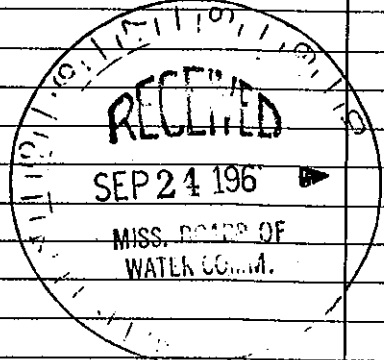

REEVES WELL AND PUMP CO.
 Phone 1250
 McCOMB, MISSISSIPPI

(Use Back Side)

Well No.

Mail this copy to Board of Water Commissioners 429 Miss. St. Jackson, Miss