

AMITE

MISSISSIPPI BOARD OF WATER COMMISSIONERS

T. 6

2-28-63

WATER WELL DRILLERS LOG

CODED

Date: 2-28, 1963, Driller: E. J. J. Lincum County

(1) Owner of Land: Minnie Holden
(Name)
Rt 2. Box 131 Liberty Miss
(Address)

(2) Location: NE SE 1/4, Sec 33 T. 6 R. 5
15 miles SE of Liberty
(distance) (direction) (Nearest Town)

(3) Topography: Hilly
(Hilly) (Flat) (Level)

(4) Purpose of Well: Domestic
(Domestic Irrigation Municipal, Industrial, Other)


Description & Color of Materials Sand, Clay, Red Clay, Shell, etc.	Thick- ness Feet	Depth Feet
Red Clay & Sand	0	30
Red Clay	30	55
Sand & Gravel	55	125

Information upon completion of well:

- (1) Diameter 4 1/2 inches.
- (2) Total Depth 125 feet.
- (3) Water Level 80 feet below top of ground.
- (4) Cased to 125, Size 2"
- (5) Screen: Size .010, Length 5'
- (6) Were any formations sealed against pollution?
 yes, No no.

If YES depth of formation _____
Why _____

Drillers Remarks: Air jitted
1" coupling on
back work valve.

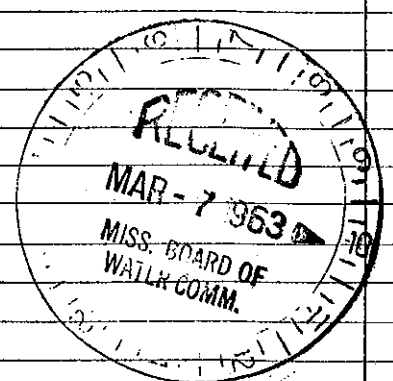

(Use Back Side)

Well No. 8

Mail this copy to Board of Water Commissioners 429 Miss. St. Jackson, Miss